


AS-BUILT PLAN FOR 1st. FLOOR LEVEL
SCALE: 3/32" = 1'-0"

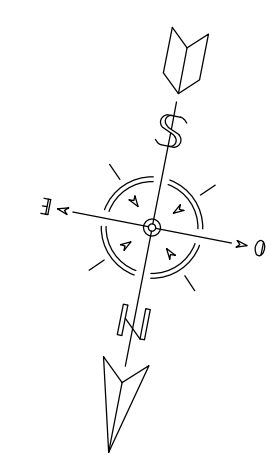

LEYENDA:

- EXISTING RECEPTACLE TO BE REMOVED.
- DUPLIX RECEPTACLE TO REMAIN @ 1'-6" A.F.F.
- TELEPHONE JACK OUTLET TO BE REMOVED.
- COMPUTER LAN CONNECTION TO BE REMOVED
- COAXIAL CABLE JACK OUTLET TO BE REMOVED
- MICROPHONE JACK PLUG AT FINISH FLOOR.
- SECURITY TV CAMARA AT WALL OR CEILING.
- SPEARKER SYSTEM AT CEILING.
- SPEARKER HORN, STROBE AT CEILING.
- POWER POLE : (UN CIRCUITO DEDICADO), (UN CIRCUITO COMUN).
- SMOKE DETECTOR.
- PANIC BUTTOM. (Installed in discreet location).
- REMOTE RELEASE LOCK BUTTOM, FOR SECURITY DOOR TO BE REMOVED

DEMOLITION NOTE:

- 01.-ALL ELECTRICAL FIXTURES INSTALLED AT DRYWALLS SHALL BE DISMOUNTED AND TREATED FOLLOWING ALL ELECTRICAL SAFETY CODES, LAST REVISION. (JUNCTION BOX, SWITCH, PANIC BUTTOM, ETC.).
- 02.-ALL ELECTRICAL FIXTURES INSTALLED AT CONCRETE BLOCK WALLS SHALL BE TO REMAIN.
- 03.-THE DOORS AND FRAME SHALL BE DISMOUNTED WITH SPECIAL CARE, CONTRACTOR MUST RETURNED TO BUILDING OWNER, (A.E.P.).
- 04.-ALL SURFACES OF THE FLOOR SHALL BE CLEAN AND POLISHED.
- 05.-DAMAGED FLOOR'S TILE UNDER DEMOLISHED WALL OR PARTITIONS SHALL BE REPLACEMENT. 60 SQ.FT IN THIS AREA.

GENERAL NOTE:

- GENERAL CONTRACTOR SHALL PROVIDE SECURITY EQUIPMENT TO ALL WORKERS ACCORDING WITH SECURITY WORKING CODE.
- SHALL LET THE AREA CLEAN AND READY FOR NEXT JOURNAL'S DAY.
- ALL WORK OR JOB CONDITIONS SHALL BE COORDINATED WITH BUILDING ADMINISTRATION AND IN ANY CASE THE WORK OR JOB WILL NOT AFFECT THE NORMAL OPERATION OF THE COURTS LABOR.
- GENERAL CONTRACTOR MUST PROVIDE A GARBAGE CONTAINER FOR ALL TRASH, AND IS RESPONSIBLE FOR THE APPROPRIATE DISPOSAL.
- GENERAL CONTRACTOR MUST PROVIDE SPECIAL CONTAINERS FOR ALL RECYCLABLE MATERIAL.

IMPORTANT NOTE:

- ALL DATA, TELEPHONE OR COMPUTER LAN'S CABLE OR CIRCUIT FIND IN DEMOLITION PROCESS, SHALL BE SAVED, ROLLED AT CEILING OR FLOOR AT THE SAME FIND PLACE.

AIR CONDITIONER NOTE:

THE AIR SUPPLY IS SHOWN IN THIS PLAN FOR CEILING INFORMATION ONLY, MECHANICAL WORK IS NOT INCLUDE IN THIS PROJECT.

REVISIONS	
NO.	DESCRIPTION

TRIBUNAL GENERAL DE JUSTICIA
OFICINA DE ADMINISTRACION DE LOS TRIBUNALES
DIRECTORIA DE ADMINISTRACION
OFICINA DE ADMINISTRACION Y CONSERVACION DE LOCALES

APPROVED BY: _____ APPROVED DATE: _____

PROJECT NAME: **DIGITALIZACION PLANOS ESTRUC. DE LA RAMA JUDICIAL**
PROJECT LOCATION: **PRIMER PISO ARCHIVO CENTRAL SAN JUAN , PUERTO RICO**
DRAWING DESCRIPTION: **PLANTA DE DEMOLICION ELECTRICA**
SHEET NO.: **AD-03**
OF: **4**

GERENTE DE PROYECTO: _____
PROYECTO DATE: **22-Agosto-2008**
CHECKED BY: **ING. DANIEL PABILLA**
DRAWING BY: **JOEL CARRION**
PRINTING DATE: **17-Marzo-2009**
FILE NAME: **1702-ARCHIVO-GENERAL.dwg**
DRAWING SCALE: **3/32"=1'-0"**