


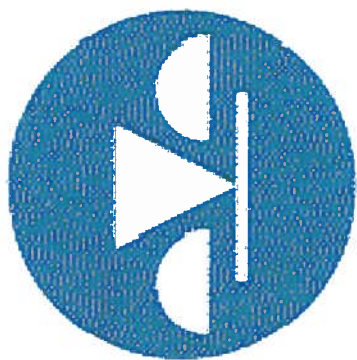


Poder Judicial
de Puerto Rico

OFICINA DE LA ADMINISTRACION DE LOS TRIBUNALES (OAT)
DIRECTORIA DE ADMINISTRACION
OFICINA DE ADMINISTRACION Y CONSERVACION DE LOCALES

PLANOS PARA CONSTRUCCIÓN:
TRIBUNAL GENERAL DE JUSTICIA
OFICINA DE ADMINISTRACIÓN DE LOS TRIBUNALES
PLANOS PARA SALON DE JURADOS, OFICINA EPA,
Y MEDIADORAS PISO 6, CU AGUADILLA, PUERTO RICO

PRESENTATION DOCUMENTS

INDEX OF DRAWINGS:

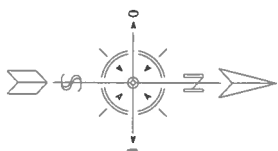

01-	TTT-01	HOJA DE TITULO
02-	AE-01	PLANTA DE PISO EXISTENTE
03-	AD-01	PLANTA DE DEMOLICION DE TECHO REFLEJADO
04-	A-01	PLANTA DE PISO PROPUESTA
05-	A-02	PLANTA PROPUESTA DE PLAFON REFLEJADO Y DETALLES
06-	A-03	PLANTA MOBILIARIO
07-	A-04	HOJA DE PUERTAS Y DETALLES TTPCOS
08-	A-05	TIPOS DE PAREDES Y DETALLES GENERALES
09-	A-06	DETALLES DE ESTRADO
10-	A-07	DETALLES DE CONSTRUCCION
11-	E-01	PLANTA DE LUCES
12-	E-02	PLANTA DE POWER

PROJECT STAFF:


Ing. Daniel Padilla Vélez / Administrador Oficina.
Ing. Daniel Padilla Vélez / Especialista de Proyecto
Sr. Pedro Morales / Delincuente

PROJECT NAME: SALA ESPECIALIZADA DE VIOLENCIA DOMESTICA	
PROJECT LOCATION: CENTRO JUDICIAL DE AGUADILLA	
DRAWING DESCRIPTIONS: HOJA DE PRESENTACION	
ESPEC. EN ADMINIST	GERENTE DE PROYECTO: M. HERNANDEZ
CHECKED BY: Joel Carrion	PROJECT DATE: 10-OCT-2024
DRAWING BY: Ing. D.PADILLA	PRINTING DATE: 17-JUNIO-2025
FILE NAME: P.MORALES	DRAWING SCALE: NONE

TRIBUNAL GENERAL DE JUSTICIA OFICINA DE ADMINISTRACION DE LOS TRIBUNALES DIRECTORIA DE ADMINISTRACION OFICINA DE ADMINISTRACION Y CONSERVACION DE LOCALES	
APPROVED BY:	
APPROVED SIGN: _____	
APPROVED DATE:	

R E V I S I O N S			
NO.	DESCRIPTION	DATE	BY

O A T

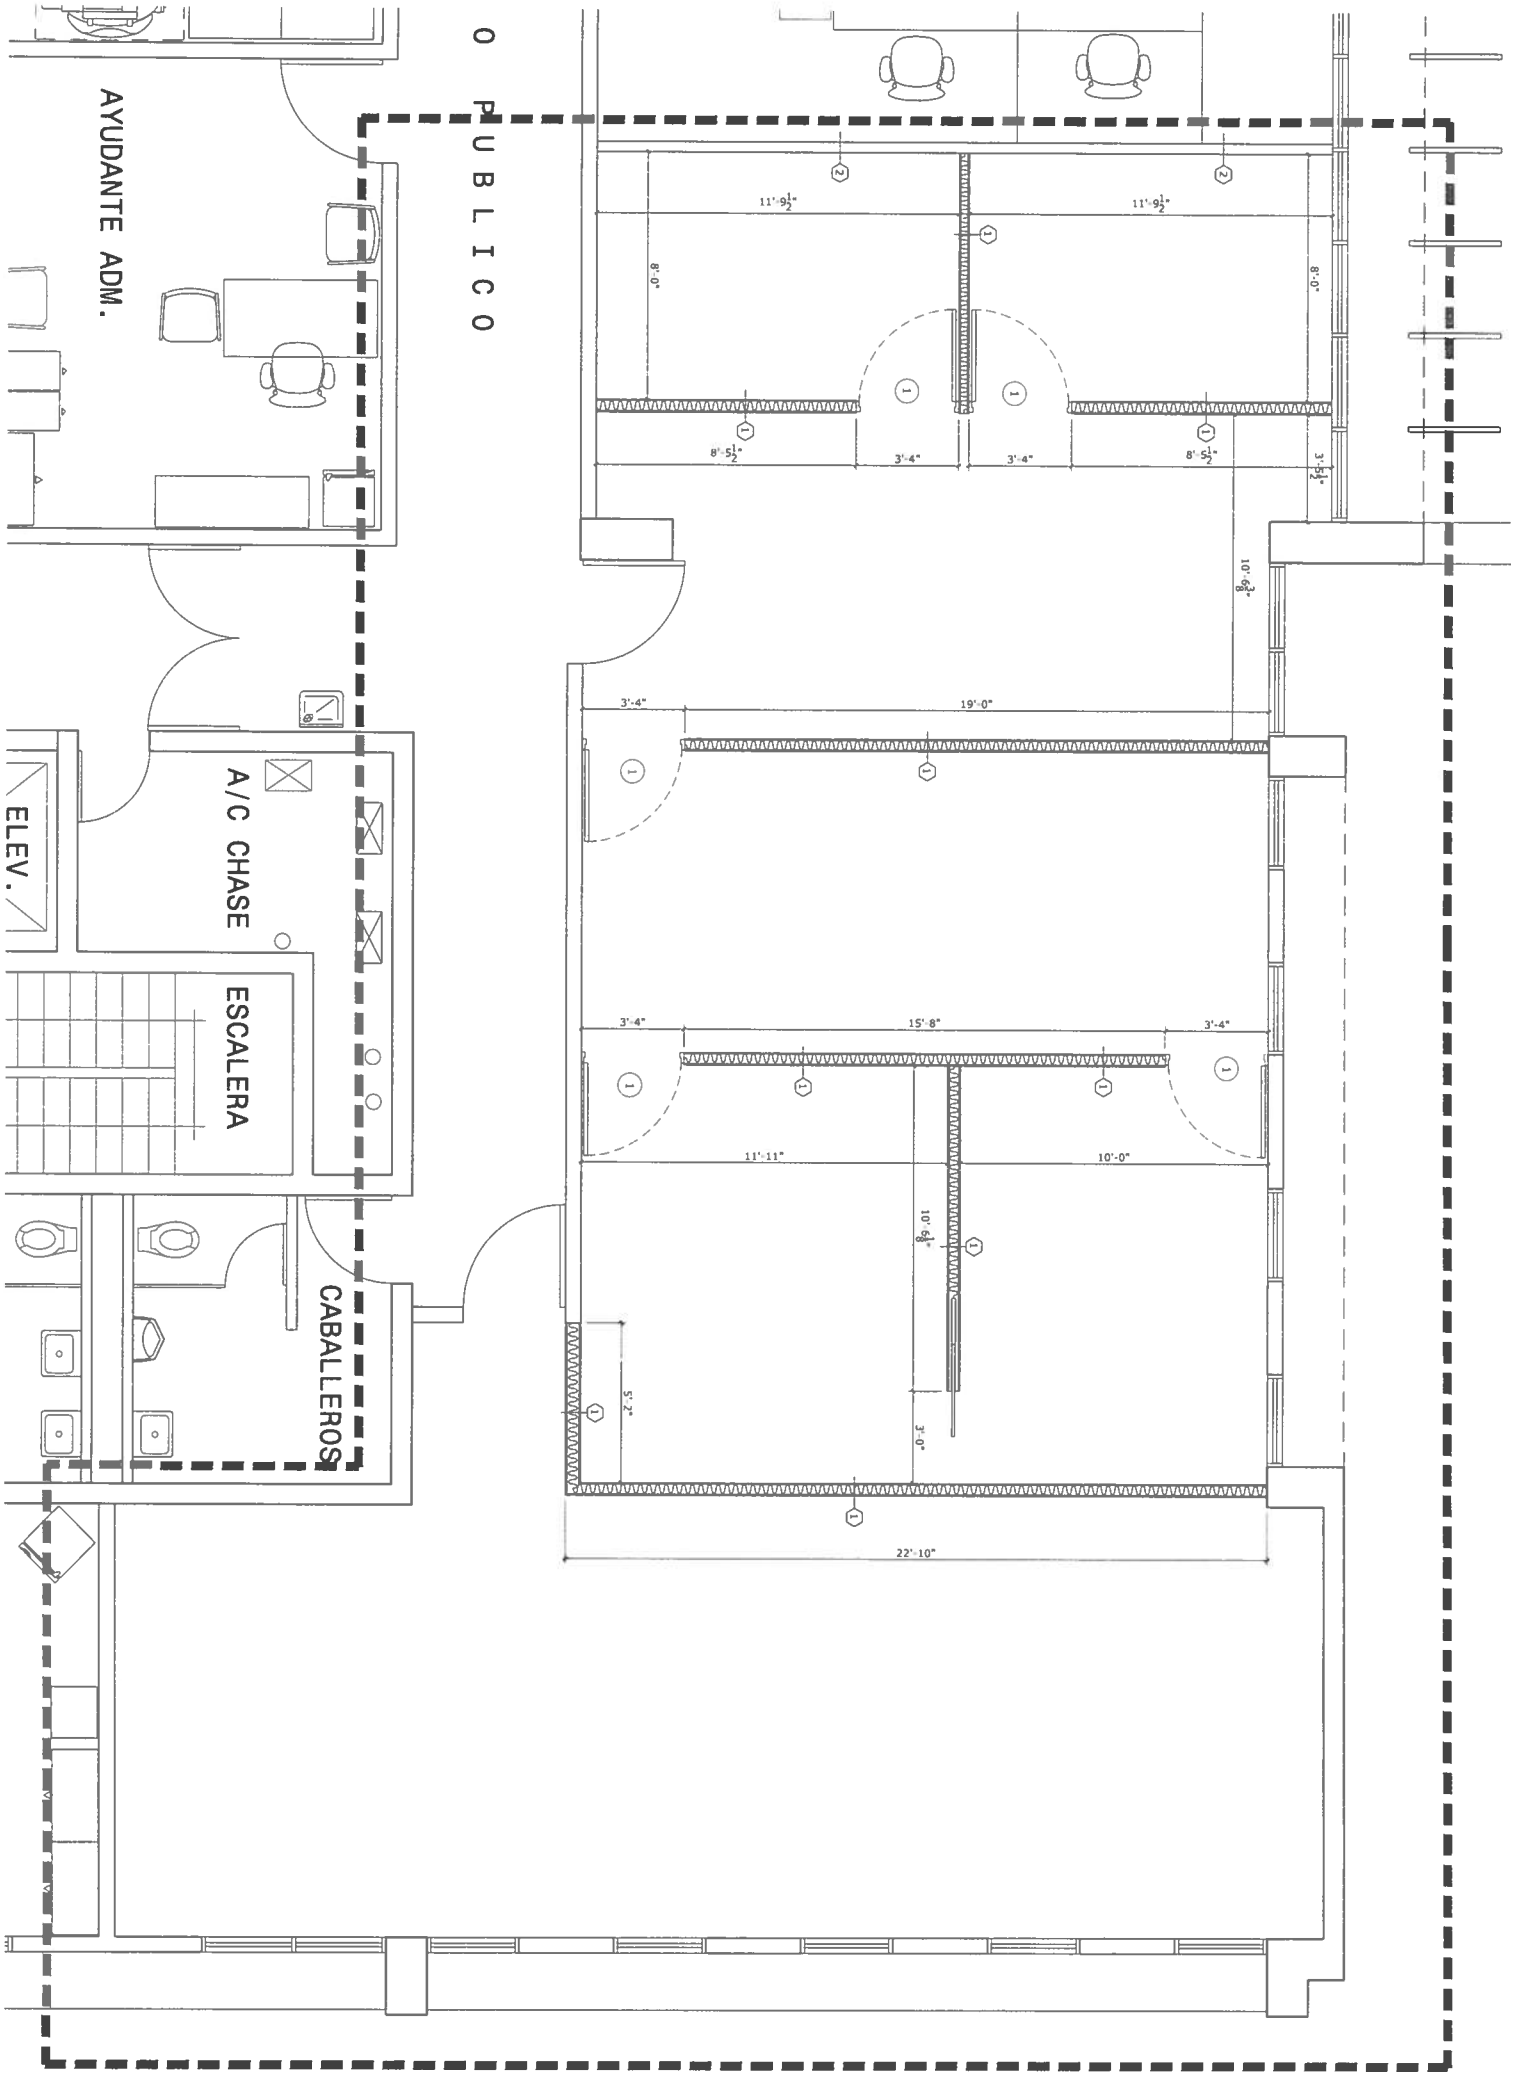

EXISTING FLOOR PLAN (SIXTH LEVEL)

SCALE: 3/8" = 1'-0"

PROJECT NAME: DIGITALIZACION PLANOS DE INSTALACIONES DEL T.G.J.			
PROJECT LOCATION: 6 to. PISO DEL CENTRO JUDICIAL DE AGUADILLA			
DRAWING DESCRIPTIONS: PLANTA EXISTENTE DEL SEXTO PISO (AS-BUILT)			
A-01	1	ESPEC. EN ADMINST.	PROJECT DATE: 22-AGO-2008
	2	CHECKED BY:	DRAWING DATE: 14-JUN-2016
	3	DRAWING BY: R. OVIEDO	PRINTING DATE: 17-JUN-2016
	4	FILE NAME: 0101-06.SIXTH FLOOR AS-BUILT.dwg	DRAWING SCALE: 3/16"=1'-0"

TRIBUNAL GENERAL DE JUSTICIA OFICINA DE ADMINISTRACION DE LOS TRIBUNALES DIRECTORIA DE ADMINISTRACION DIVISION DE LOCALES Y SERVICIOS ESPECIALES	
APPROVED BY:	
APPROVED DATE:	

R E V I S I O N S			
NO.	DESCRIPTION	DATE	BY





PROPOSED CEILING FLOOR PLAN (SIXTH LEVEL)

SCALE: 3/8" = 1'-0"

LEGEND:


- 2'-0"x4'-0" ACOUSTICAL HUNG CEILING
- 2'-0"x2'-0" LIGHTING FIXTURE SEE ELECTRICAL DRAWING
- 4" SPOT LED LIGHT FIXTURE
- LIGHTING FIXTURE EMERGENCY
- EXIT LIGHTING FIXTURE
- CAMERA FIXTURE
- EXISTING AC 2'x2' RETURN
- EXISTING AC 2'x2' SUPPLY

PROJECT NAME DIGITALIZACION PLANOS DE INSTALACIONES DEL T.G.J.			
PROJECT LOCATION 6 to. PISO DEL CENTRO JUDICIAL DE AGUADILLA			
DRAWING DESCRIPTIONS PLANTA EXISTENTE DEL SEXTO PISO (AS-BUILT)			
PROJECT NO. A-02	DESIGNED BY ESPEC. EN ADMINIST.		PROJECT DATE 22-AGO-2008
	CHECKED BY		DRAWING DATE 14-JUN-2016
	DRAWING BY R. OVIEDO		PRINTING DATE 17-JUN-2016
	FILE NAME 0101-06.SIXTH FLOOR AS-BUILT.dwg		DRAWING SCALE 3/16"=1'-0"

TRIBUNAL GENERAL DE JUSTICIA OFICINA DE ADMINISTRACION DE LOS TRIBUNALES DIRECTORIA DE ADMINISTRACION DIVISION DE LOCALES Y SERVICIOS ESPECIALES	
APPROVED BY:	
APPROVED DATE:	

R E V I S I O N S			
NO.	DESCRIPTION	DATE	BY



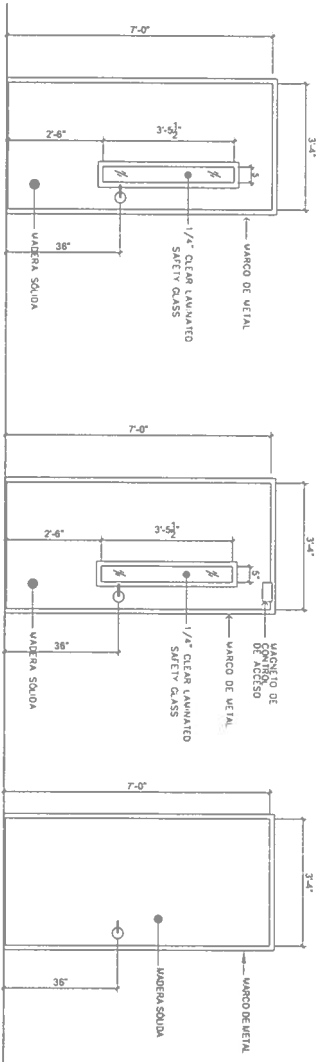

PUERTA TIPO I

PUERTA TIPO II

PUERTA TIPO III

ELEVACIÓN DE PUERTAS

NO A ESCALA

RELACIÓN DE PUERTAS							
MKD	ABERTURA		TAMAÑO DE PUERTA			TIPO	CANTIDAD
	ANCHO	ALTURA	ANCHO	ALTURA	ESPESOR		
①	3'-0"	7'-0"	3'-0"	7'-0"	1-3/4"	METAL	4
②	3'-0"	7'-0"	3'-0"	7'-0"	1-3/4"	METAL	II
③	3'-0"	7'-0"	3'-0"	7'-0"	1-3/4"	METAL	III
OBSERVACIONES							
PUERTA TIPO I: MARCO DE METAL, VIGIERA SÓLIDA, 1/4\"/>							
PUERTA TIPO II: MARCO DE METAL, VIGIERA SÓLIDA, 1/4\"/>							
PUERTA TIPO III: MARCO DE METAL, VIGIERA SÓLIDA, 1/4\"/>							

NOTAS:

- TODAS LAS PAREDES A CONSTRUIRSE LLEVAN INSULACIÓN (R=19).
- GYPSUM BOARD A INSTALARSE DE 5/8" DE ESPESOR.
- GYPSUM BOARD A UTILIZAR FIRE RATED DE 1 HORA SEGÚN CÓDIGO ASIM.
- PINTURA A UTILIZARSE SHERWIN WILLIAMS (CREMA CLARO #6385).
- PRIMER A UTILIZARSE SHERWIN WILLIAMS PROMAR 200.
- TODAS LAS PAREDES A CONSTRUIRSE LLEVAN ZÓCALO EN VINYL COLOR GRIS #209 DE 4".
- LOZA DE PISO A UTILIZARSE IGUAL AL EXISTENTE.
- LOS "METAL STUDS" GALVANIZADOS GAUGE 20, ESPACIADOS @ 18" CENTRO A CENTRO.
- TINTE A UTILIZARSE EN LAS PUERTAS COLOR EXPRESSO.
- LAMINADO A UTILIZARSE EN LOS TOPES MODELO LAMITECH CHERRY 1801M1.

PROJECT NAME	
OFICINAS VIOLENCIA DE GENERO, RD FAMILIA, U. SOCIAL	
PROJECT LOCATION	
PISO 3 TORRE "A" CENTRO JUDICIAL DE CAROLINA PUERTO RICO	
DRAWING DESCRIPTIONS:	
NOTAS Y DETALLES	
A-4	DESIGNED BY: ING. DOMINIAN SANTOS
	CERENTE DE PROYECTO:
	CHECKED BY: ING. PAZILIA
	DRAWING BY: P.MORALES
FILE NAME	
DRAWING SCALE: 3/8"=1'-0"	

TRIBUNAL GENERAL DE JUSTICIA
OFICINA DE ADMINISTRACION DE LOS TRIBUNALES
DIRECTORIA DE ADMINISTRACION
OFICINA DE ADMINISTRACION Y CONSERVACION DE LOCALES

APPROVED BY:

APPROVED SIGN:

APPROVED DATE:

R E V I S I O N S			
NO.	DESCRIPTION	DATE	BY


O
A
T

R E V I S I O N S			
NO.	DESCRIPTION	DATE	BY


TRIBUNAL GENERAL DE JUSTICIA
OFICINA DE ADMINISTRACION DE LOS TRIBUNALES
DIRECTORIA DE ADMINISTRACION
OFICINA DE ADMINISTRACION Y CONSERVACION DE LOCALES

APPROVED BY: _____
APPROVED SIGN: _____ APPROVED DATE: _____


PROJECT NAME: REMODELACION DE ARCHIVO CENTRAL	
PROJECT LOCATION: PRIMER PISO ARCHIVO CENTRAL SAN JUAN , PUERTO RICO	
DRAWING DESCRIPTIONS: TIPOS DE PAREDES Y DETALLES GENERALES	
ESPEC. EN ADMINIST. OSCAR HERNANDEZ	GERENTE DE PROYECTO:
CHECKED BY: DANIEL PADILLA	PROJECT DATE:
DRAWING BY: P.MORALES	PRINTING DATE: FEBRERO-2024
FILL NAME:	DRAWING SCALE: 1/4"=1'-0"

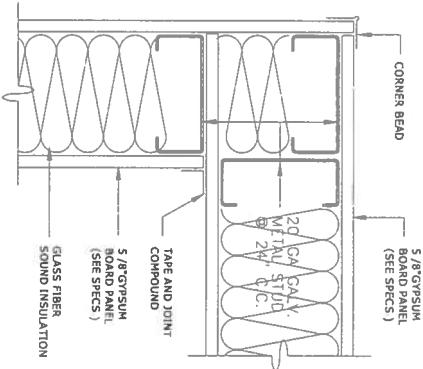


WALL CORNER CONDITION
NOTES

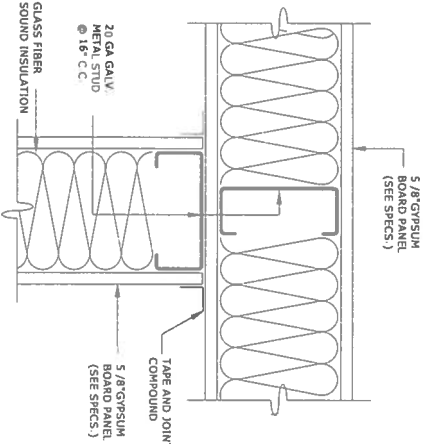


WALL INTERSECTION CONDITION
NOTES (PAINTER)

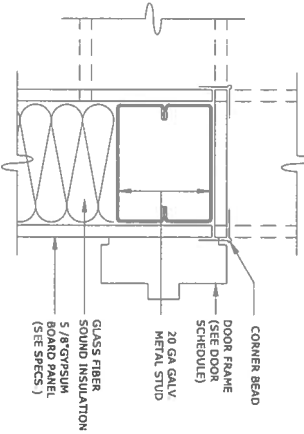


DOOR FRAME CONNECTION
NOTES

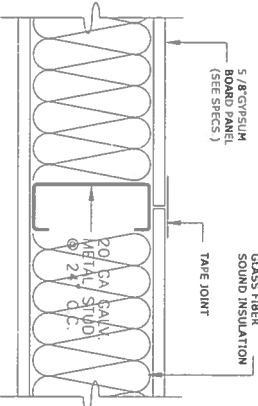

WALL SECTION PANEL
JOINT PLAN VIEW
NOTES

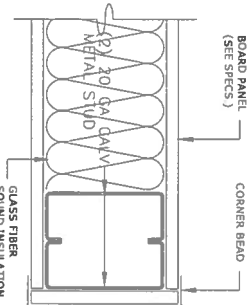


WALL END
NOTES

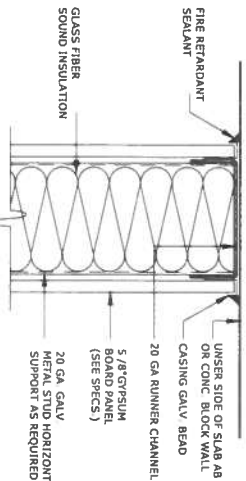


WALL OR CEILING
ANCHORAGE SECTION
NOTES



INTERMEDIATE STUD
SUPPORT SECTION
NOTES

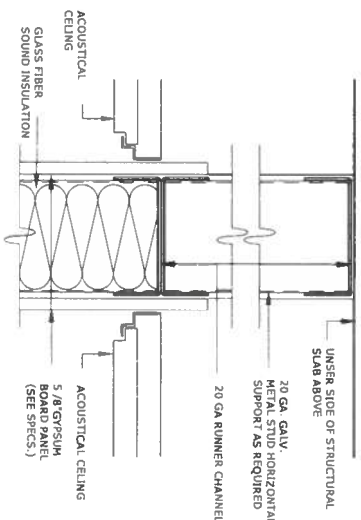

CEILING ANCHORAGE SECTION
NOTES

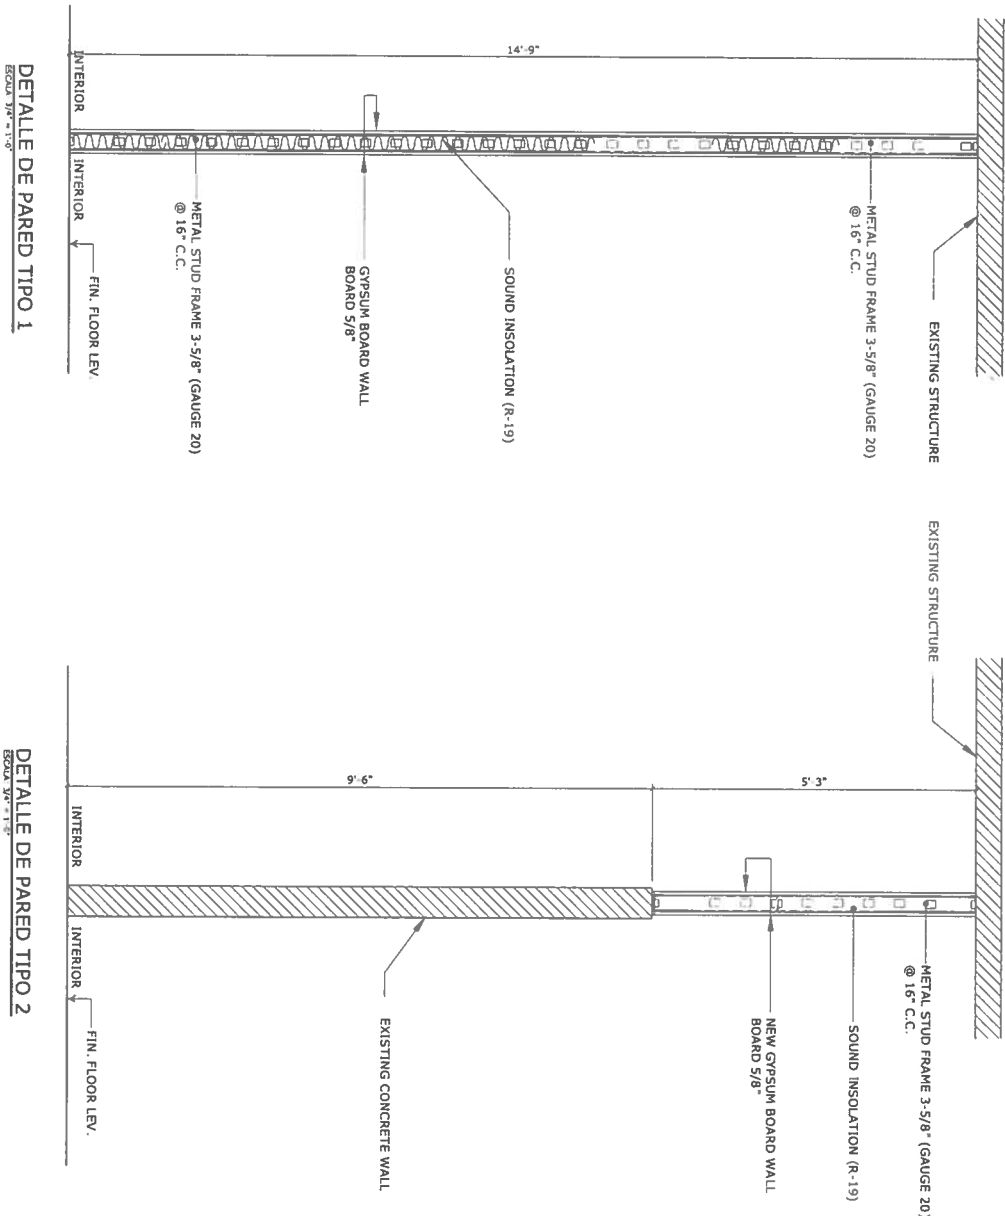


DETAILLE DE PARED TIPO 1
Escala 1/4"=1'-0"

DETAILLE DE PARED TIPO 2
Escala 3/4"=1'-0"

NOTAS:


- * TODAS LAS PAREDES A CONSTRUIRSE LLEVAN INSULACIÓN (R-19).
- * GYPSUM BOARD A INSTALARSE DE 5/8" DE ESPESOR.
- * GYPSUM BOARD A UTILIZAR FIRE RATED DE 1 HORA SEGÚN CÓDIGO ASTM.
- * PINTURA A UTILIZARSE SHERWIN WILLIAMS PROMAR 400 EGGSHELL (SW 7006 EXTRA WHITE).
- * PRIMER A UTILIZARSE SHERWIN WILLIAMS PROMAR 200.
- * TODAS LAS PAREDES A CONSTRUIRSE LLEVAN ZÓCALO EN VINYL DE 4" COLOR GRIS.
- * LOZA DE PISO A UTILIZARSE IGUAL AL EXISTENTE.
- * LOS "METAL STUDS" GALVANIZADOS GAUGE 20, ESPACIADOS @ 16" CENTRO A CENTRO.
- * LA INSTALACIÓN DE LAS PUERTAS INCLUYE MARCO.
- * TINTE A UTILIZARSE EN LAS PUERTAS COLOR EXPRESO.

FLOOR ANCHORAGE DET. SECTION
NOTES

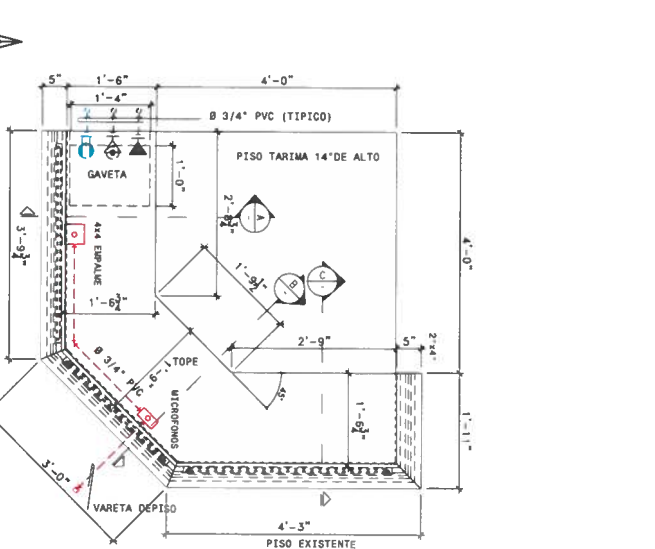


PLANO AGRANDADO DE ESTRADO

SCALE: 3/4"=1'-0"

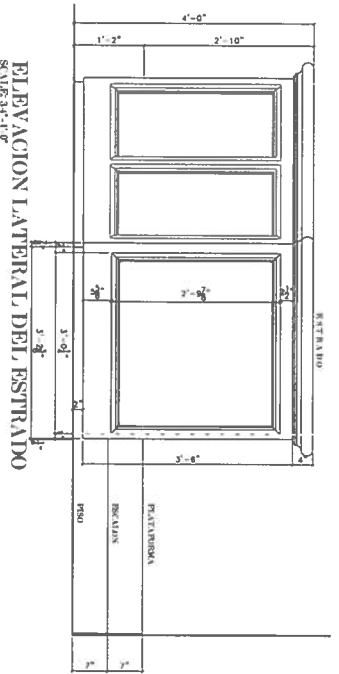


ELEVACION LATERAL DEL ESTRADO

SCALE: 3/4"=1'-0"

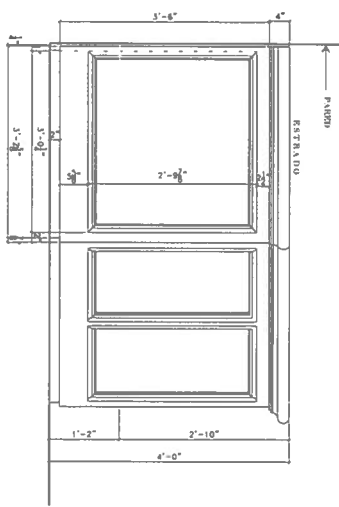


ELEVACION FRONTAL DEL ESTRADO

SCALE: 3/4"=1'-0"

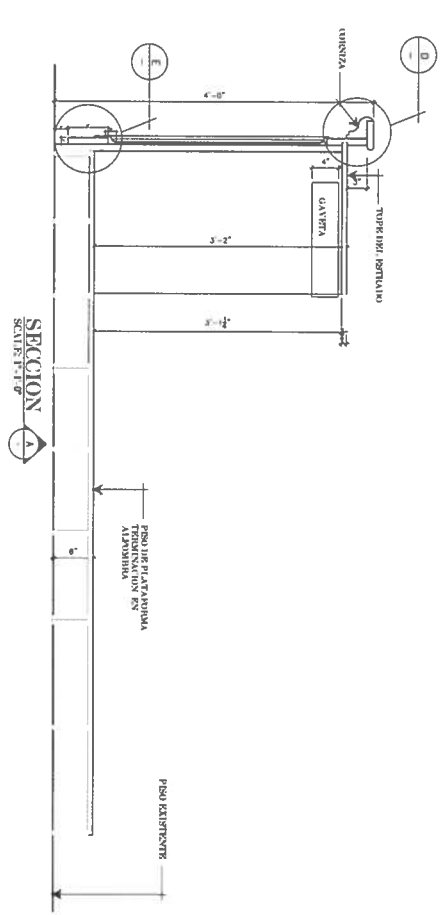


SECCION A-A

SCALE: 1/2"=1'-0"

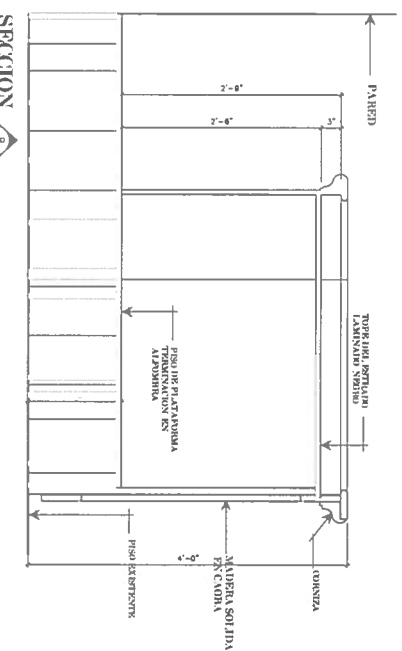



SECCION B-B

SCALE: 1/2"=1'-0"

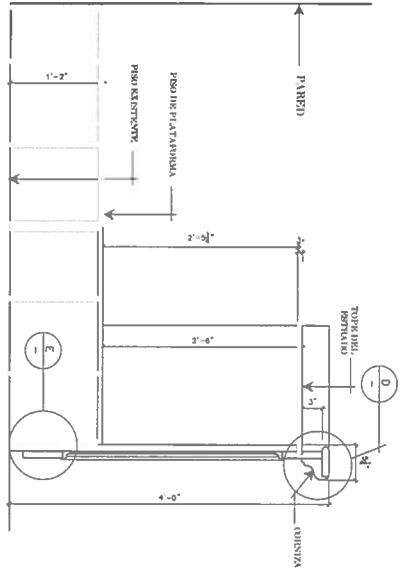


SECCION C-C

SCALE: 1/2"=1'-0"

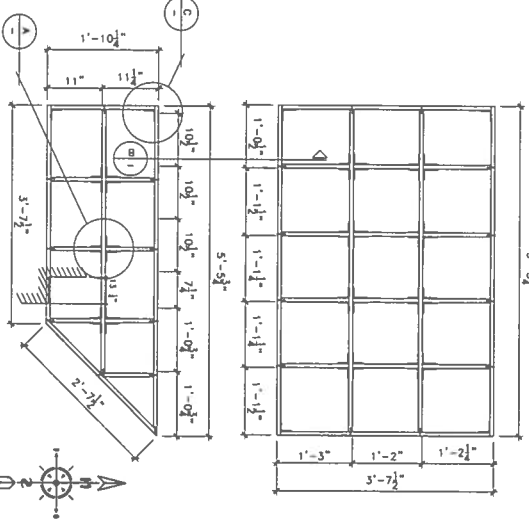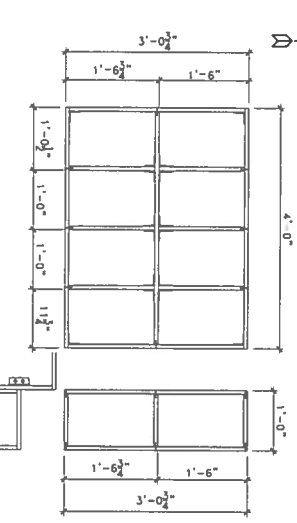



DETALLE ESTRUCTURA DE LA TARIMA

SCALE: 3/4"=1'-0"

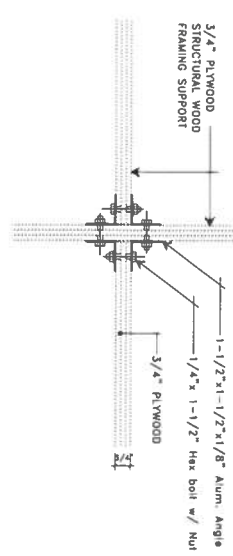


DETALLE EMPALME DE PANELS

SCALE: 3/4"=1'-0"

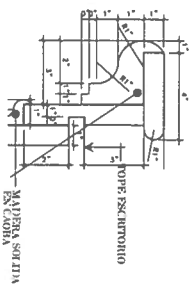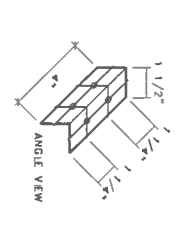


DETALLE D

SCALE: 3/4"=1'-0"

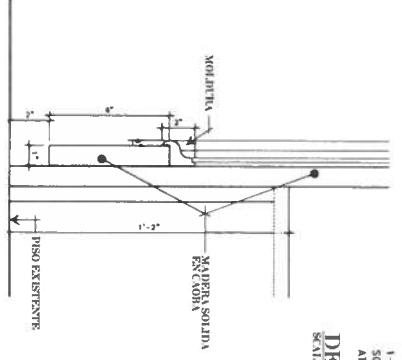


DETALLE E

SCALE: 3/4"=1'-0"

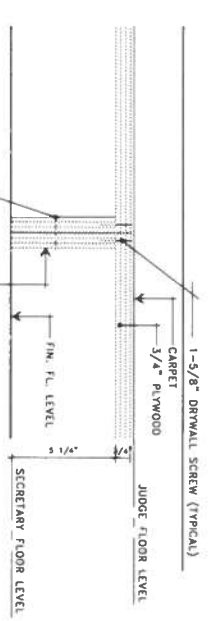

DETALLE UNION DE TARRAS

SCALE: 3/4"=1'-0"

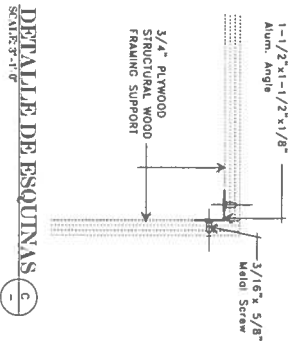

DETALLE DE ESQUINAS

SCALE: 3/4"=1'-0"

NOTA:


- Toda la madera a ser utilizada en la fabricación de la tarima del estrado, será: paneles tratados de 3/4" de espesor en Pino Blanco.
- Toda la madera a ser utilizada en la fabricación del estrado y/o la baranda, será: Caoba, pulida y lustrada con barniz marino.



PROJECT NAME: Remodelacion de los tribunales de Primera Instancia	
PROJECT LOCATION: Region Judicial de Mayaguez, T.P.I. de Cabo Rojo	
DRAWING DESCRIPTIONS: Detalle de Construcción de Estrado	
DRAWING NO: A-06	
DRAWING DATE: 04-Junio-2012	
DRAWING SCALE: Indicada	
DRAWING FILE NAME: 1003-municipal courtroom.dwg	

PROJECT NAME: Remodelacion de los tribunales de Primera Instancia	
PROJECT LOCATION: Region Judicial de Mayaguez, T.P.I. de Cabo Rojo	
DRAWING DESCRIPTIONS: Detalle de Construcción de Estrado	
DRAWING NO: A-06	
DRAWING DATE: 04-Junio-2012	
DRAWING SCALE: Indicada	
DRAWING FILE NAME: 1003-municipal courtroom.dwg	

REVISIONS			
NO.	DESCRIPTION	DATE	BY

APPROVED BY:	
APPROVED SIGN:	
APPROVED DATE:	

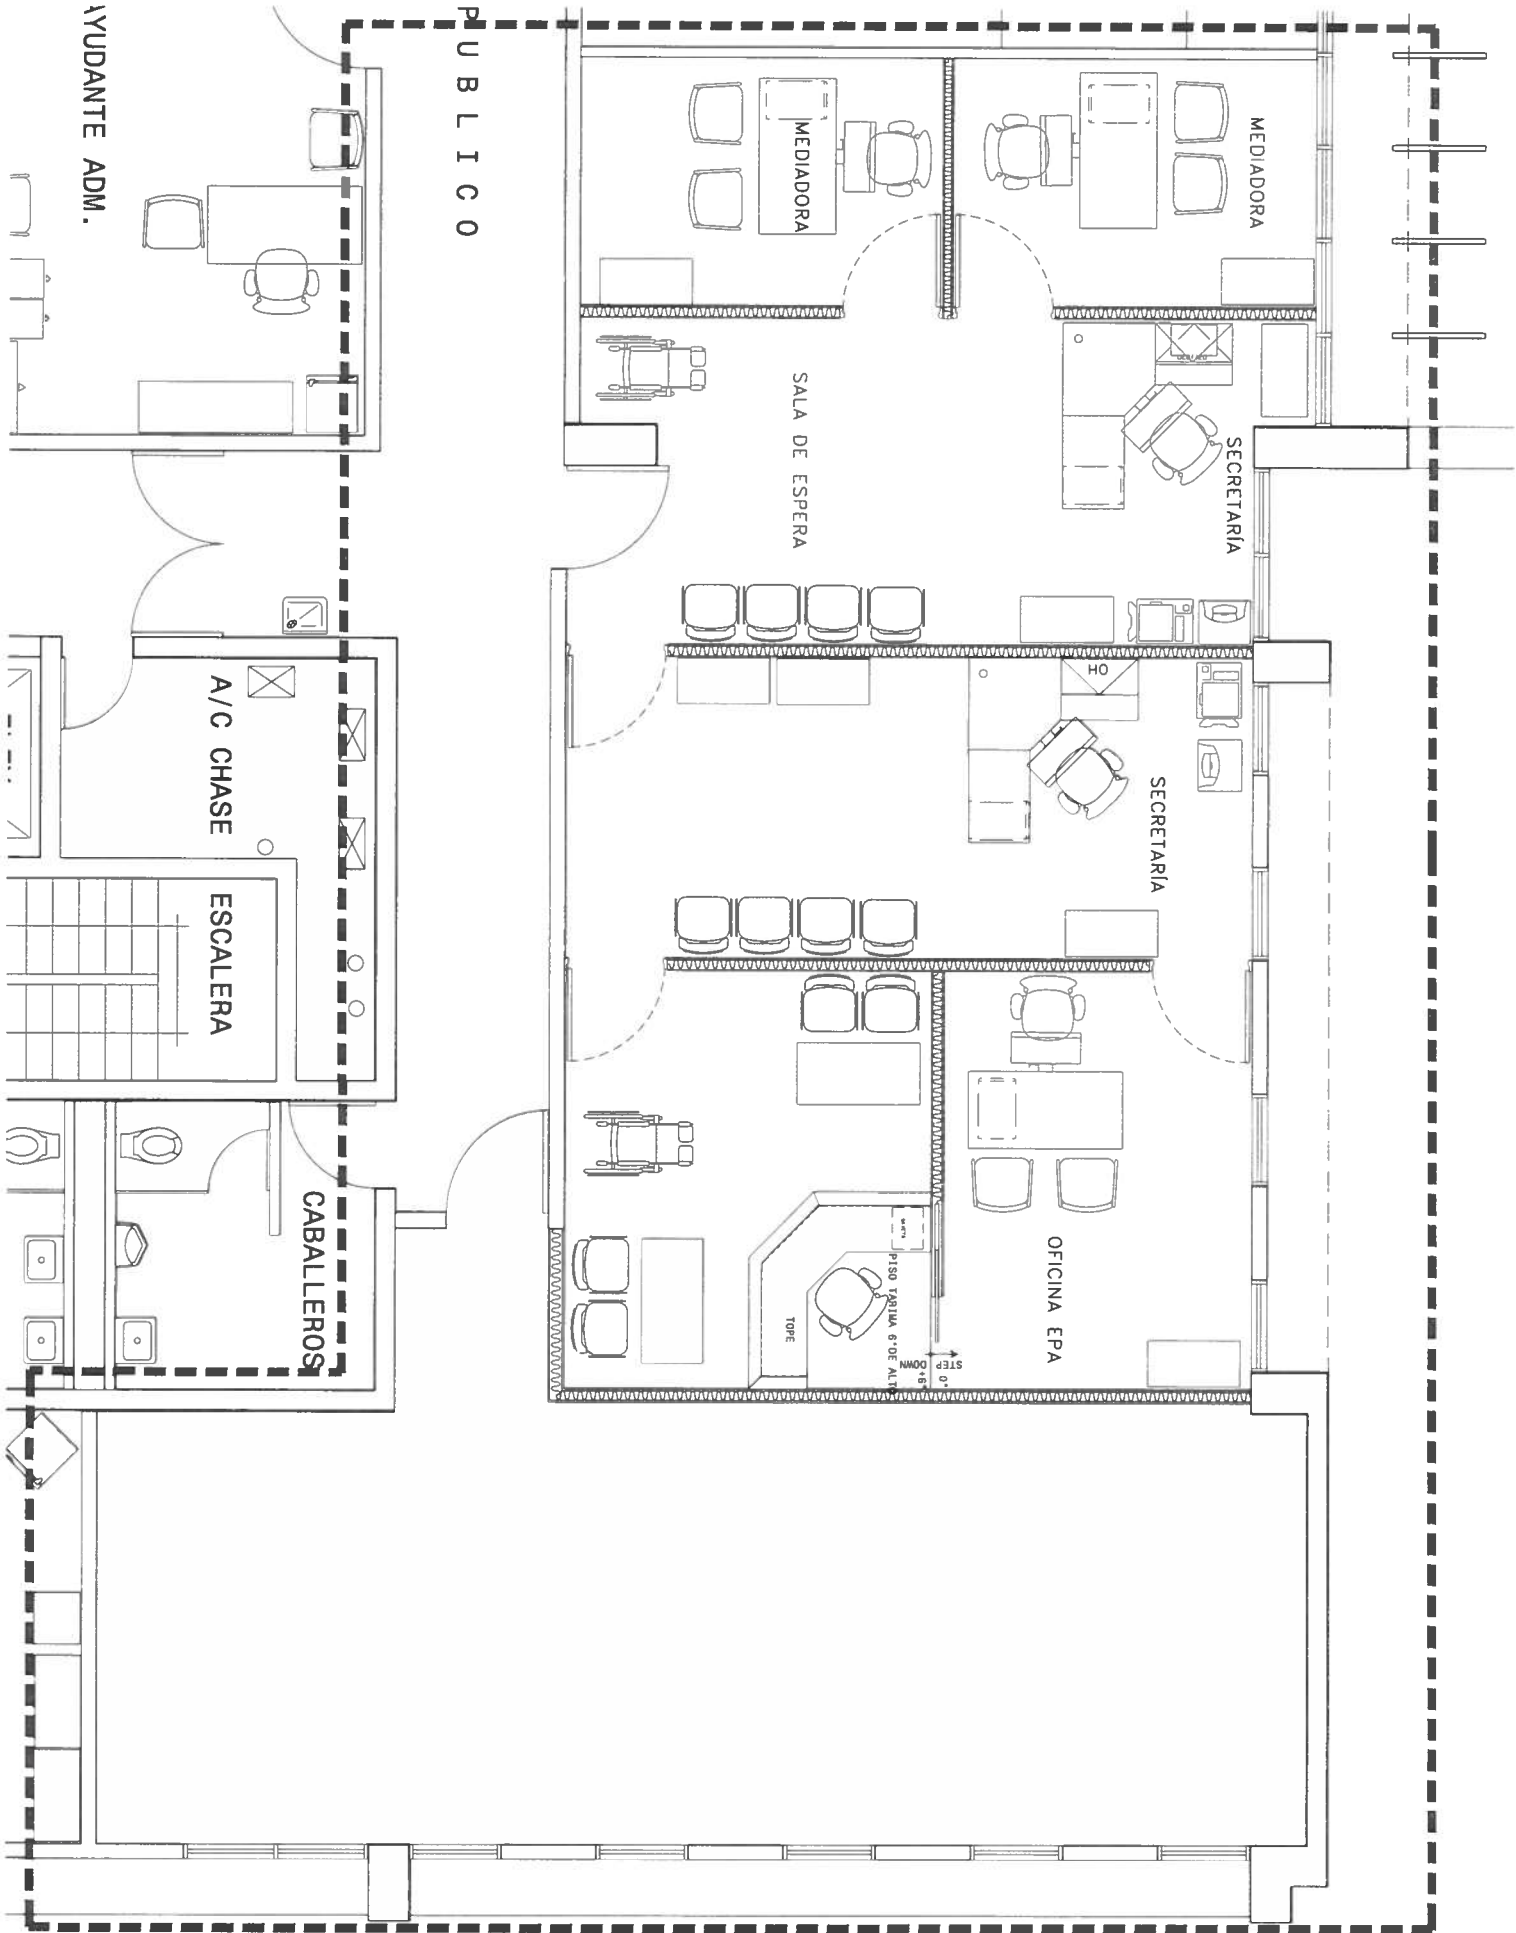

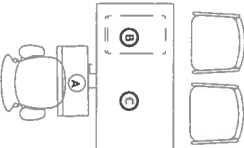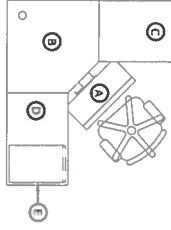ESTACIÓN 1			CANTIDAD 3
MKD	Quantity	Product Description	
A	1	Dial-g-Tilt Short Track Keyboard Arm, Teflon Slide, Base Swivel+10°/-15° (23"W x 10.5"D)	
B	2	Pedestol, 22"d, File, File	
C	1	Rectangular Work surface With End Panel, 30"d x 60"w	
			
ESTACIÓN 2			CANTIDAD 2
MKD	Quantity	Product Description	
A	1	Dial-g-Tilt Short Track Keyboard Arm, Teflon Slide, Base Swivel+10°/-15° (23"W x 10.5"D)	
B	1	90° Corner Worksurface, 36" w x 24"d	
C	1	Rectangular Worksurface With End Panel, 30"d x 24"w	
D	1	Rectangular Worksurface With End Panel, 24"d x 36" w	
E	1	Pedestol, 22"d, Box, Box, File	
			
SILLA TIPO I			CANTIDAD 6
			
Product Description			
Silla ejecutiva acolchada con ruedas.			
SILLA TIPO II			CANTIDAD 18
			
Product Description			
Silla plastica color negro, sin ruedas.			


PROJECT NAME			
DIGITALIZACION PLANOS DE INSTALACIONES DEL T.G.J.			
PROJECT LOCATION			
6 to. PISO DEL CENTRO JUDICIAL DE AGUADILLA			
DRAWING DESCRIPTIONS			
PLANTA EXISTENTE DEL SEXTO PISO (AS-BUILT)			
PROJECT NO. A-03	CHECKED BY: R. OVIEDO		PROJECT DATE: 22-AGO-2008
	DRAWING BY: R. OVIEDO		DRAWING DATE: 14-JUN-2016
	FILE NAME: 0101-06.SIXTH FLOOR AS-BUILT.dwg		PRINTING DATE: 17-JUN-2016
			DRAWING SCALE: 3/16"=1'-0"

APPROVED BY:	
APPROVED DATE:	


TRIBUNAL GENERAL DE JUSTICIA
OFICINA DE ADMINISTRACION DE LOS TRIBUNALES
DIRECTORIA DE ADMINISTRACION
DIVISION DE LOCALES Y SERVICIOS ESPECIALES

R E V I S I O N S			
NO.	DESCRIPTION	DATE	BY

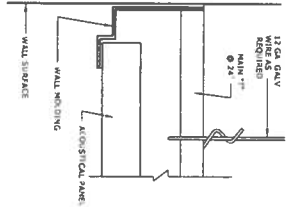


SHADOW MOLDING WALL,
ANGLE MOUNTED DETAIL.

NOT TO SCALE

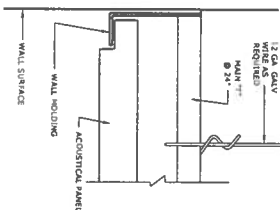


WALL ANCHORED TYP. DETAIL.

NOT TO SCALE

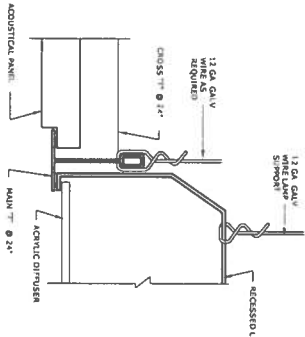

LAMP SUPPORT TYPICAL DETAIL.

NOT TO SCALE

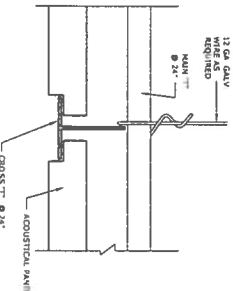

CROSS T\"/>

NOT TO SCALE

General Notes:

ALL CEILING SYSTEM SHALL BE NEW AS SPECIFICATION IN THIS SHEET
AIR CONDITIONERS SHALL BE REINSTALLED BEFORE CEILING INSTALLATION
ALL WALL THAT BE ERECTED UNTIL CEILING SLAB SHALL BE INSTALLED FIRST
ALL WALLS SHALL BE PAINTED BEFORE INSTALL THE SUSPENDED CEILING

AIR CONDITIONER NOTE:

THE AIR SUPPLY IS SHOWN IN THIS PLAN FOR CEILING INFORMATION ONLY.
MECHANICAL WORK IS NOT INCLUDE IN THIS PROJECT

CONSTRUCTION NOTE:

1- THE FISSED SHALL BE


LAY IN TYPE
-5/8\"/>

2 ALL CEILING LAMP SHALL BE:

-ELECTRONIC BALLASTS DESIGNED FOR 18 LAMPS
-3\"/>

3 THE HUNG CEILING FRAMING SHALL BE:

-WHITE COLOR
-3\"/>

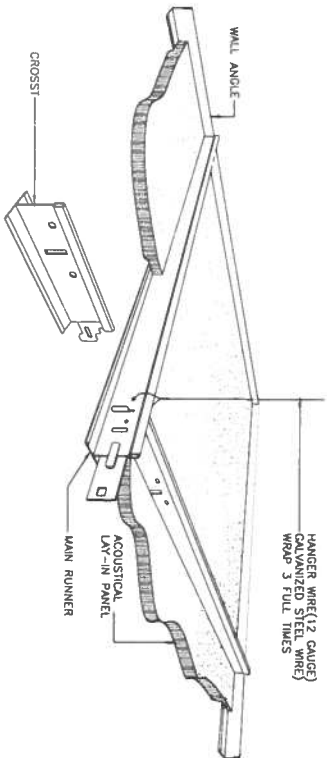ACOUSTICAL HUNG CEILING
ASSEMBLY DETAIL-ISOMETRIC VIEW

NOT TO SCALE

PROJECT NAME: REMDELACION DE ARCHIVO CENTRAL	
PROJECT LOCATION: PRIMER PISO ARCHIVO CENTRAL SAN JUAN , PUERTO RICO	
DRAWING DESCRIPTIONS: DETALLES TÍPICOS DE CONSTRUCCION	
BY ESPEC. EN ARCHITECT OSCAR HERNANDEZ	GERENTE DE PROYECTO:
CHECKED BY DANIEL PADILLA	PROJECT DATE:
DRAWING BY P. MUÑOZ	PRINTING DATE: FEBRERO-2023
FILE NAME:	DRAWING SCALE: AS SHOWN


TRIBUNAL GENERAL DE JUSTICIA
OFICINA DE ADMINISTRACION DE LOS TRIBUNALES
DIRECTORIA DE ADMINISTRACION
OFICINA DE ADMINISTRACION Y CONSERVACION DE LOCALES

APPROVED BY:

APPROVED SIGN: _____

APPROVED DATE:

REVISIONS			
NO.	DESCRIPTION	DATE	BY

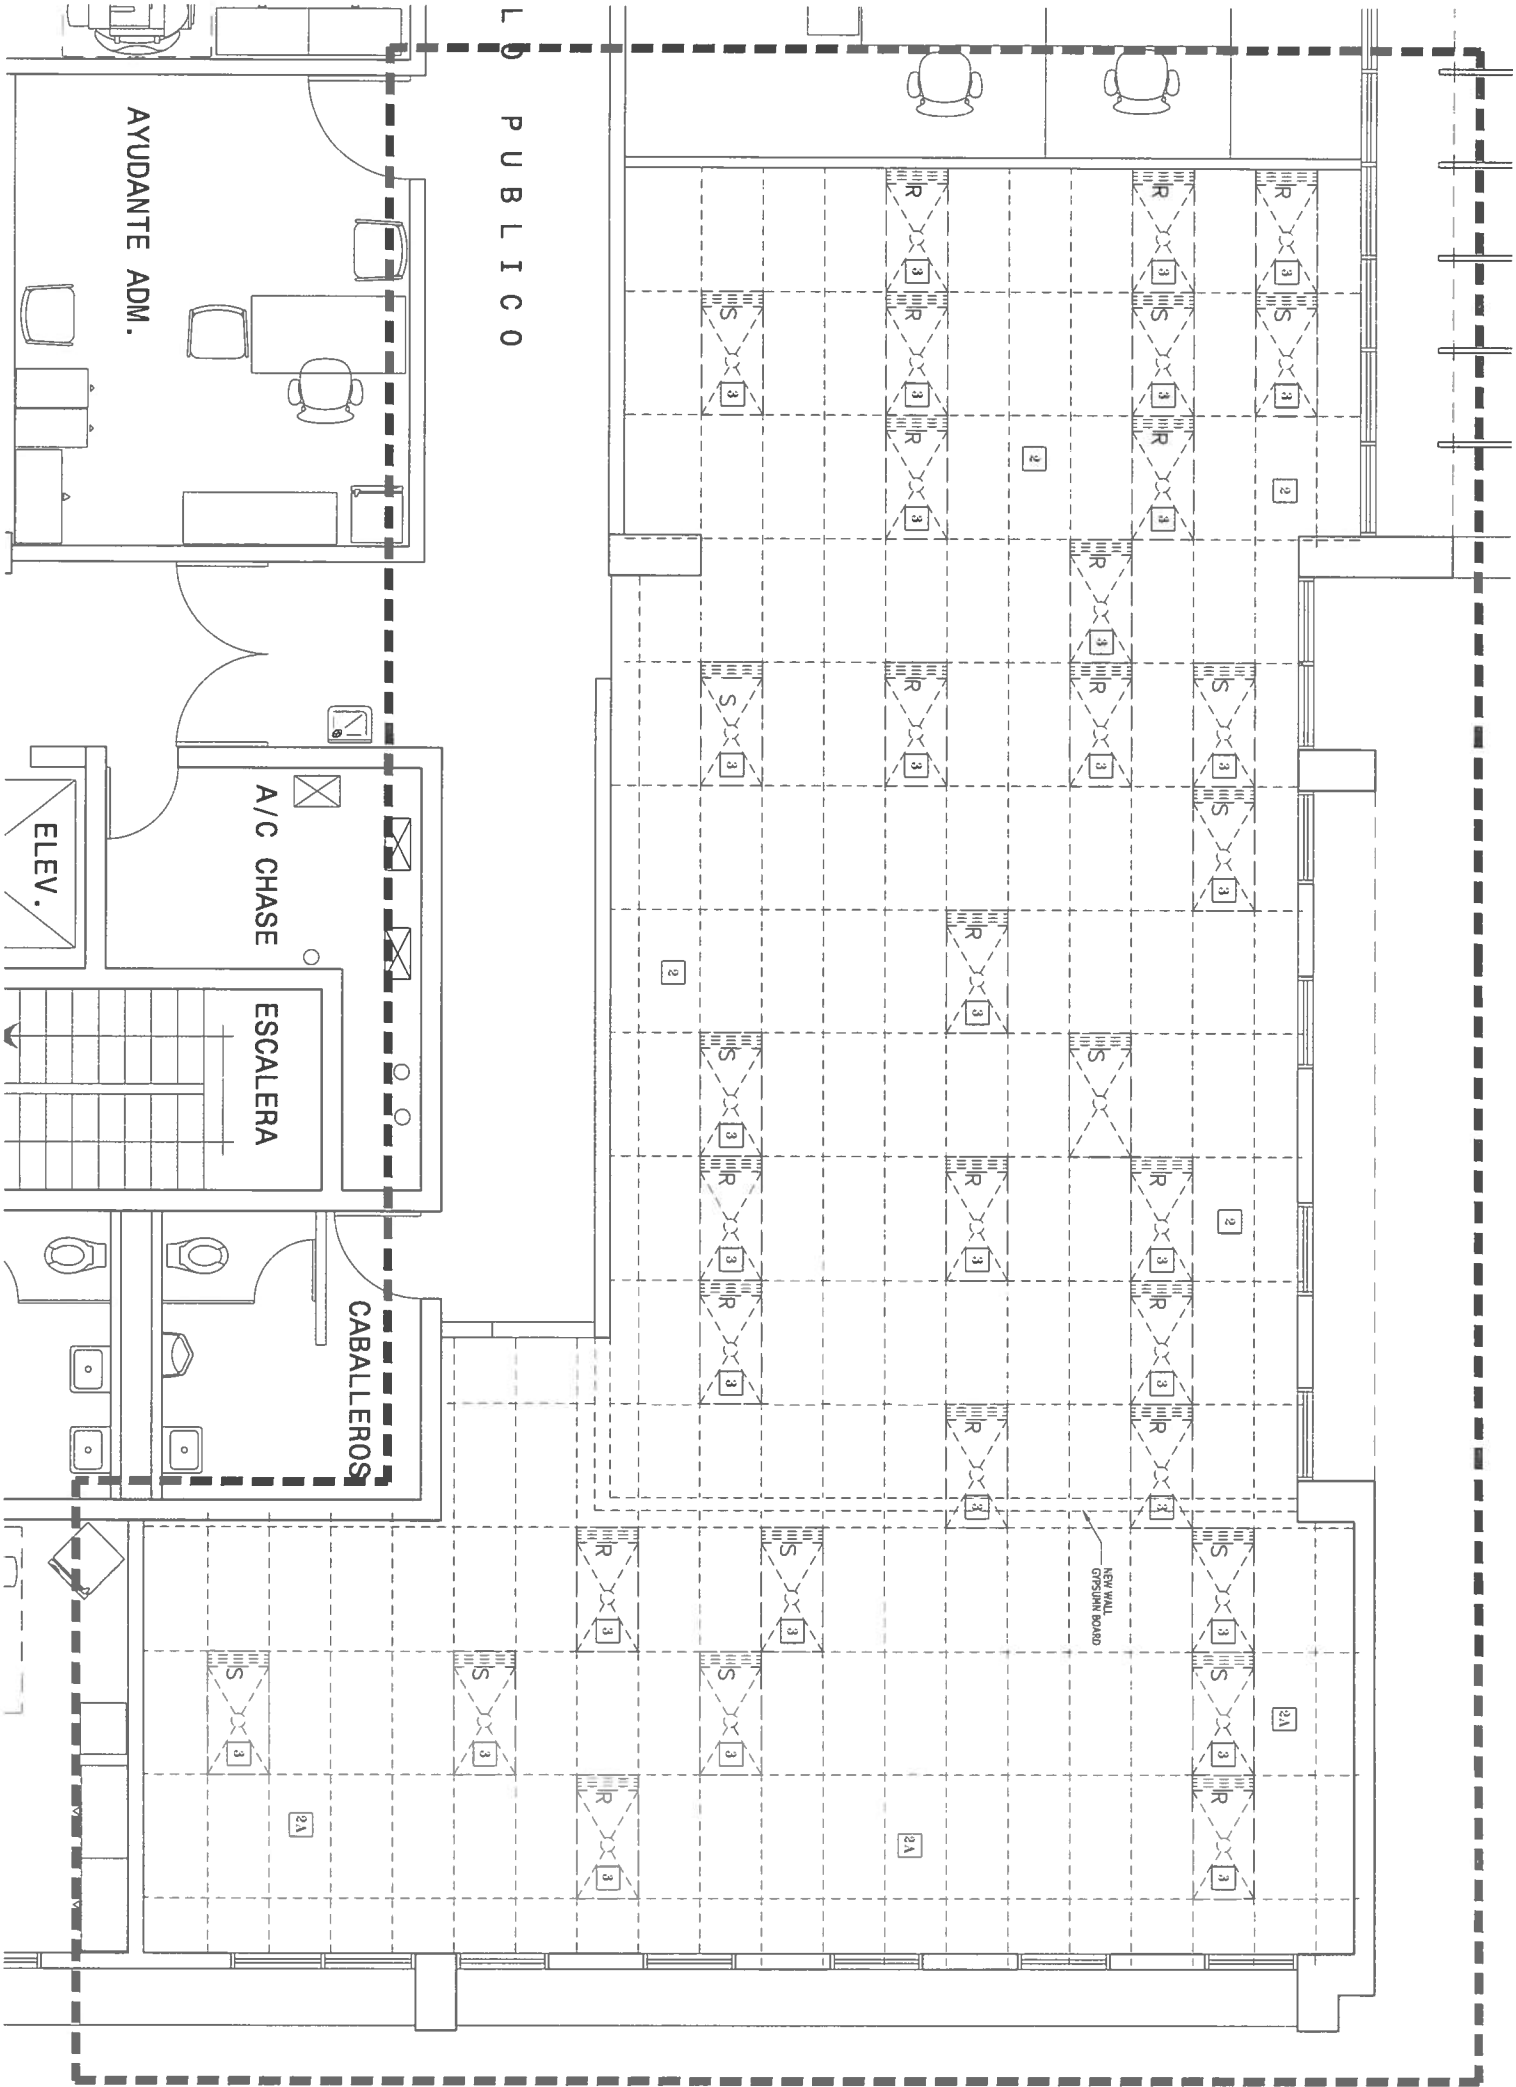

EXISTING CEILING DEMOLITION (SIXTH LEVEL)

SCALE 3/8" = 1'-0"

DEMOLITION LEGEND:

- EXISTING CEILING SPOTLIGHT TO BE REMOVED
- AREA OF ACOUSTICAL HUNG CEILING SYSTEM TO BE REMOVED
- AREA OF ACOUSTICAL HUNG CEILING SYSTEM TO REMAIN
- EXISTING CEILING LAMPS AND SUPPLY TO BE REMOVED

PROJECT NAME: DIGITALIZACION PLANOS DE INSTALACIONES DEL T.G.J.	
PROJECT LOCATION: 6 to. PISO DEL CENTRO JUDICIAL DE AGUADILLA	
DRAWING DESCRIPTIONS: CEILING DEMOLITION DEL SEXTO PISO (AS-BUILT)	
CHECKED BY: R. OVIEDO	PROJECT NO: AD-01
DRAWING BY: R. OVIEDO	PROJECT NO: AD-01
FILE NAME: 0101-06.SIXTH FLOOR AS-BUILT.dwg	PROJECT NO: AD-01
PROJECT DATE: 22-AGO-2008	PROJECT NO: AD-01
DRAWING DATE: 14-JUN-2016	PROJECT NO: AD-01
PRINTING DATE: 17-JUN-2016	PROJECT NO: AD-01
DRAWING SCALE: 3/16"=1'-0"	PROJECT NO: AD-01

TRIBUTAL GENERAL DE JUSTICIA OFICINA DE ADMINISTRACION DE LOS TRIBUNALES DIRECTORIA DE ADMINISTRACION DIVISION DE LOCALES Y SERVICIOS ESPECIALES	
APPROVED BY:	
APPROVED DATE:	

R E V I S I O N S			
NO.	DESCRIPTION	DATE	BY





PROPOSED LIGHT FLOOR PLAN (SIXTH LEVEL)

SCALE:3/8" = 1'-0"

- LEGEND:
- 2'-0" x 4'-0" ACOUSTICAL HUNG CEILING
 - NEW 2'x4' WHITE FLAT PANEL LED LIGHT, 3200 MINIMUM LUMENS, 4000K LIGHT TEMPERATURE, TO BE INSTALLED
 - NEW EXIT SIGN AND EMERGENCY LED TWO LIGHT COMBO, WITH BATTERY BACKUP OF 60 MINUTES RUN TIME OR MORE, RATED UL 924, UL DAMP, LOCK ON, AND NFPA 101, TO BE INSTALLED
 - NEW LED TWO LIGHT EMERGENCY FRAME WITH BATTERY BACKUP OF 60 MINUTES RUN TIME OR MORE, RATED UL 924, UL DAMP, LOCK ON, AND NFPA 101, TO BE INSTALLED
 - NEW ELECTRICAL BREAKER PANEL, EQUAL OR SMALLER TO SQUARED 100amp, 240V, 1P, 100, 101, TO BE INSTALLED
 - NEW ELECTRICAL BREAKER PANEL, EQUAL OR SMALLER TO SQUARED 100amp, 240V, 1P, 100, 101, TO BE INSTALLED
 - NEW 2 AMP, FOUR WAY WHITE COMMERCIAL GRADE SWITCH, TO BE INSTALLED
 - NEW 2 AMP, THREE WAY WHITE COMMERCIAL GRADE SWITCH, TO BE INSTALLED
 - NEW 2 AMP, SINGLE WHITE COMMERCIAL GRADE SWITCH, TO BE INSTALLED

- NOTES:
1. SHALL BE USE EMT TUBING, MINIMUM SIZE 3/4"Ø
 2. ALL SWITCHES AND COVER SHALL BE WHITE COLOR
 3. ALL LIGHTING CIRCUITS SHALL BE CONNECTED TO THE NEW ELECTRICAL BREAKER PANEL, TO BE INSTALLED
 4. ALL NEW CIRCUITS SHALL BE IDENTIFIED IN THE CONDUCTORS, AND IN THE ELECTRICAL PANEL LEGEND
 5. ALL NEW ELECTRICAL BREAKER PANEL, SHALL BE IDENTIFIED WITH LABEL
 6. SHALL BE INSTALL AN 800VA, 120/240VOLT SURGE PROTECTION DEVICE TO THE NEW ELECTRIC PANEL, PL-1, USING A 50AMP, 120/240V TWO-POLE CIRCUIT BREAKER
 7. UNDER ANY CIRCUMSTANCE SHOULD BE REMOVED OR CONNECT AN ENERGIZED ELECTRICAL SYSTEM, ALL SOURCE OF POWER SHALL BE TURNED OFF AND LOCK OUT DURING WORKING TIME FRAME

PROJECT NAME: DIGITALIZACION PLANOS DE INSTALACIONES DEL T.G.J.			
PROJECT LOCATION: 6 to. PISO DEL CENTRO JUDICIAL DE AGUADILLA			
DRAWING DESCRIPTIONS: PLANTA EXISTENTE DEL SEXTO PISO (AS-BUILT)			
PROJECT NO. E-01	CHECKED BY: R. OVIEDO	PROJECT DATE: 22-AGO-2008	
	DRAWING BY: R. OVIEDO	DRAWING DATE: 14-JUN-2016	
	FILE NAME: 0101-06.SIXTH FLOOR AS-BUILT.dwg	PRINTING DATE: 17-JUN-2016	
		DRAWING SCALE: 3/16"=1'-0"	


TRIBUNAL GENERAL DE JUSTICIA
OFICINA DE ADMINISTRACION DE LOS TRIBUNALES
DIRECTORIA DE ADMINISTRACION
DIVISION DE LOCALES Y SERVICIOS ESPECIALES

APPROVED BY:

APPROVED DATE:

R E V I S I O N S			
NO.	DESCRIPTION	DATE	BY

A
T

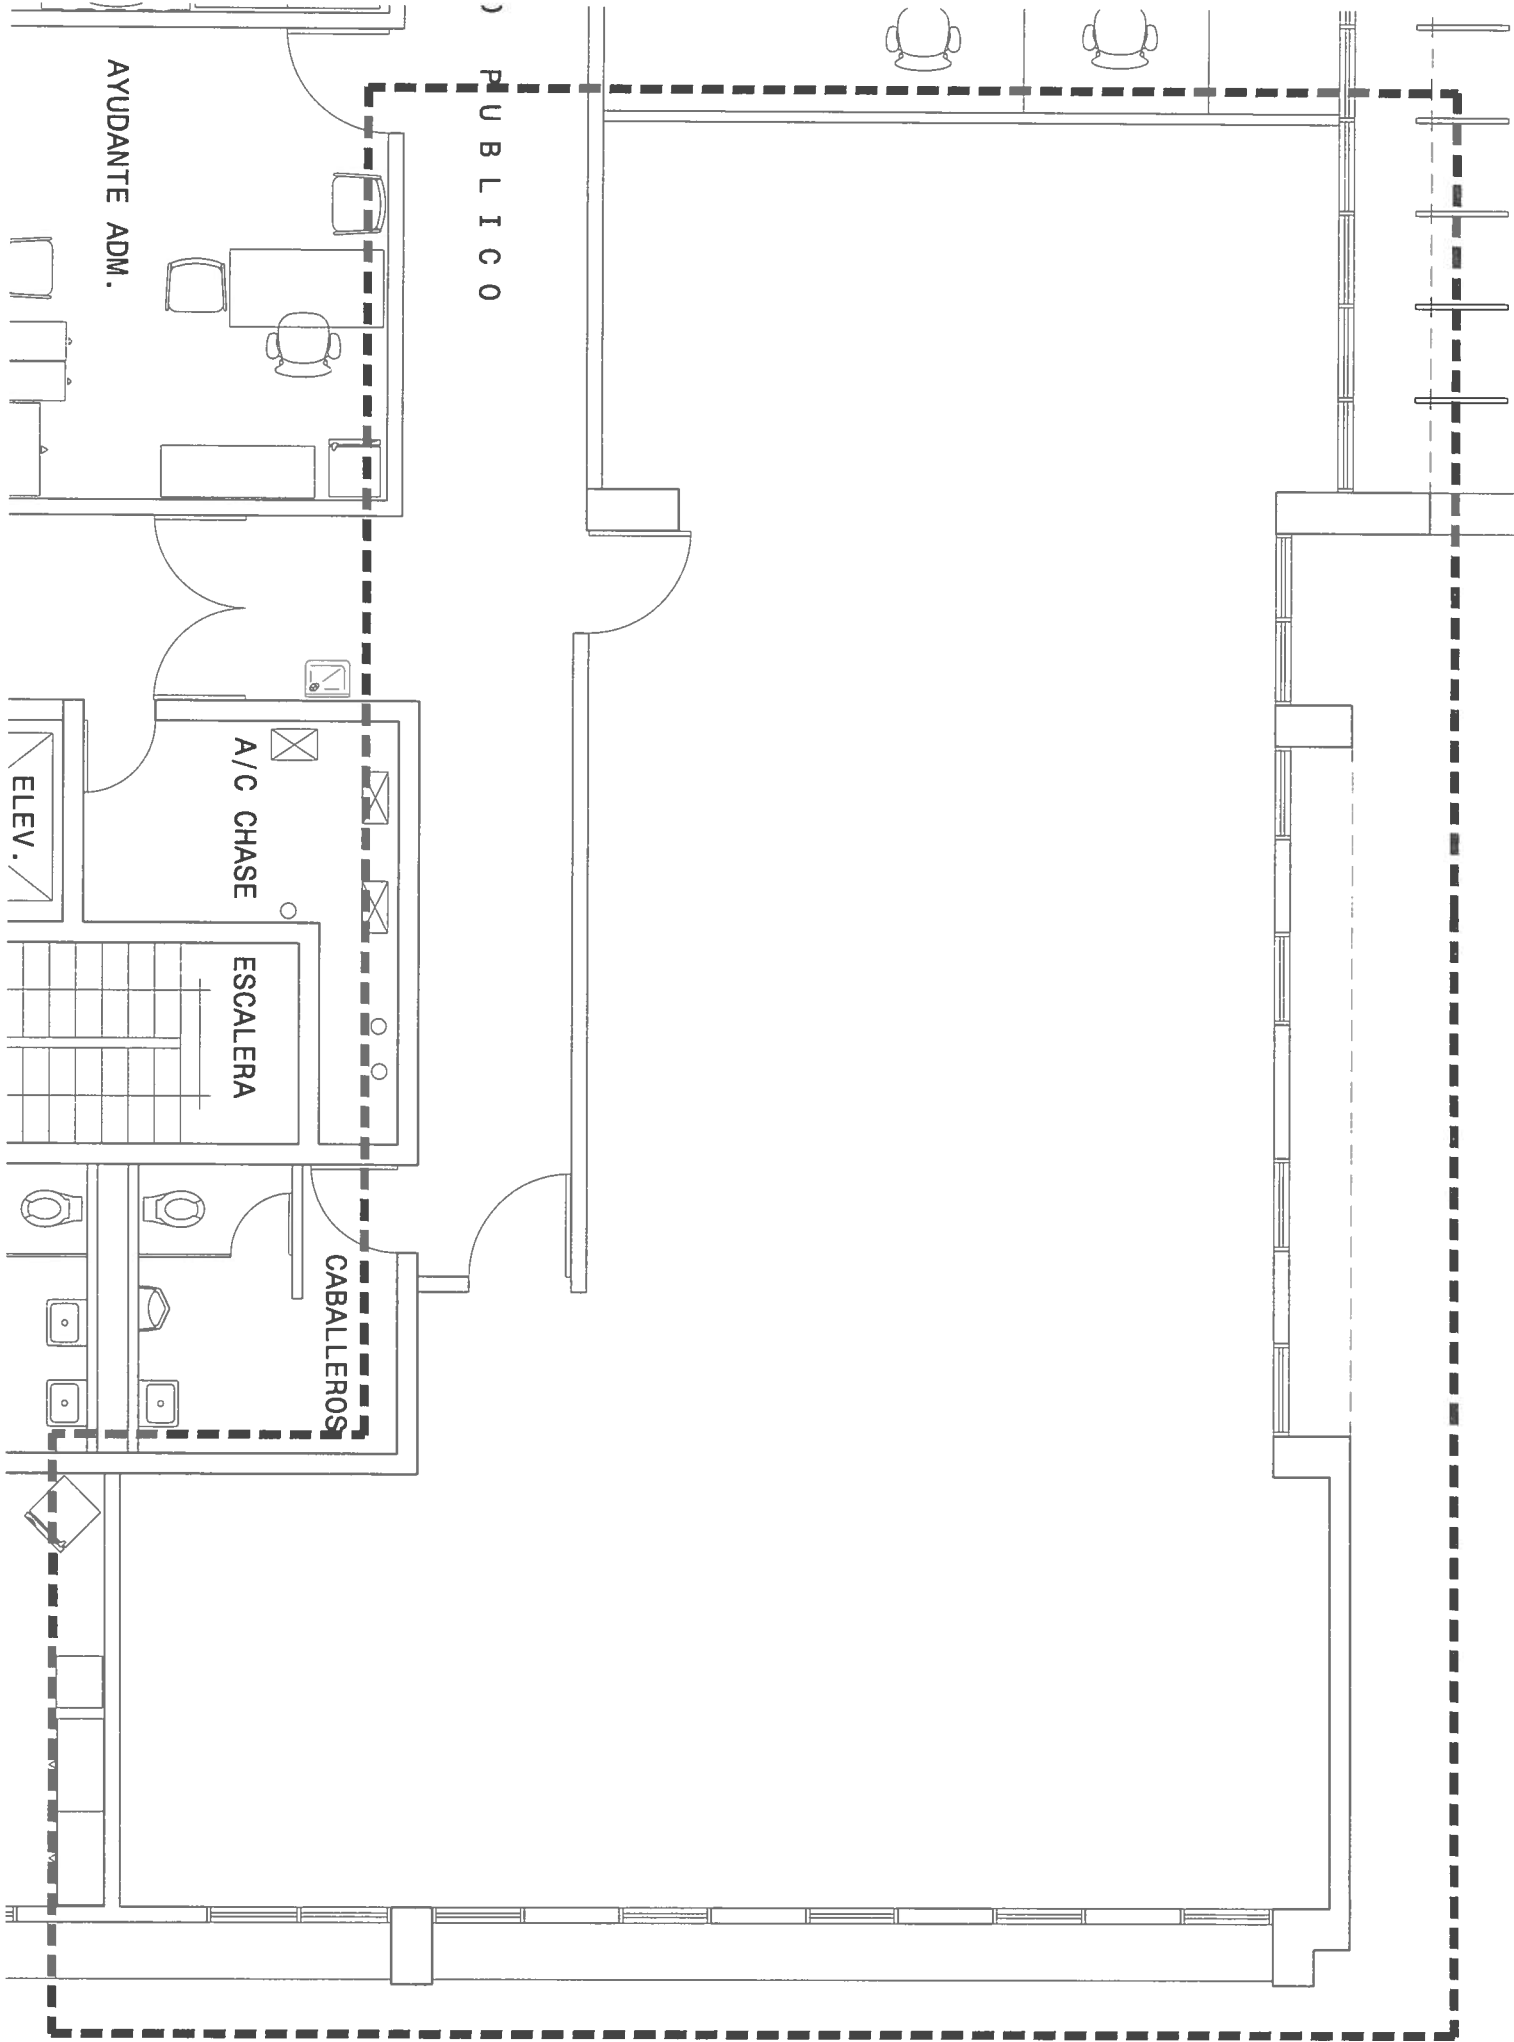

EXISTING FLOOR PLAN (SIXTH LEVEL)
SCALE:3/8"=1'-0"

PROJECT NAME: DIGITALIZACION PLANOS DE INSTALACIONES DEL T.G.J.			
PROJECT LOCATION: 6 to. PISO DEL CENTRO JUDICIAL DE AGUADILLA			
DRAWING DESCRIPTIONS: PLANTA EXISTENTE DEL SEXTO PISO (AS-BUILT)			
PROJECT NO. EX-01	CHECKED BY: R. OVIEDO		PROJECT DATE: 22-AGO-2008
	DRAWING BY: R. OVIEDO		DRAWING DATE: 14-JUN-2016
	FILE NAME: 0101-06.SIXTH FLOOR AS-BUILT.dwg		PRINTING DATE: 17-JUN-2016
			DRAWING SCALE: 3/16"=1'-0"

TRIBUNAL GENERAL DE JUSTICIA OFICINA DE ADMINISTRACION DE LOS TRIBUNALES DIRECTORIA DE ADMINISTRACION DIVISION DE LOCALES Y SERVICIOS ESPECIALES	
APPROVED BY: 	
APPROVED DATE:	

R E V I S I O N S			
NO.	DESCRIPTION	DATE	BY

