

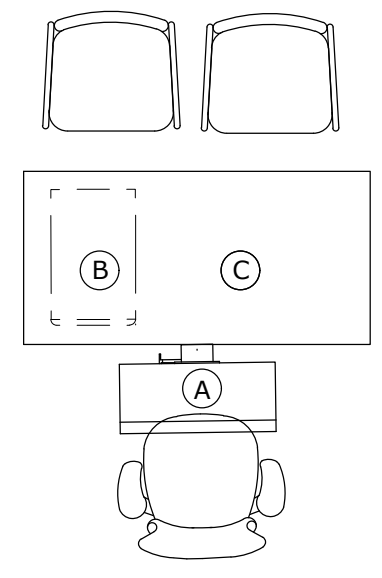


ESTACIÓN 1		CANTIDAD 2
MKD	Quantity	Product Description
A	1	Dial-a-Tilt Short Track Keyboard Arm, Teflon Slide, Base Swivel, +10°/-15° (25"W x 10.5"D)
B	2	Pedestal, 22"d, File, File
C	1	Rectangular Work surface With End Panel, 30"d x 60"w

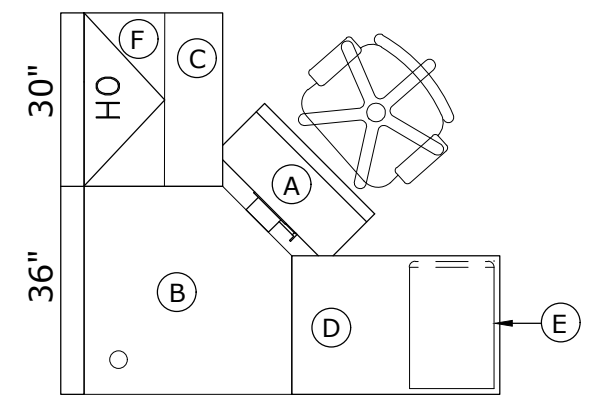


ESTACIÓN 2		CANTIDAD 3
MKD	Quantity	Product Description
A	1	Dial-a-Tilt Short Track Keyboard Arm, Teflon Slide, Base Swivel, +10°/-15° (25"W x 10.5"D)
B	1	90° Corner Worksurface, 36"w x 24"d
C	1	Rectangular Worksurface With End Panel, 30"d x 24"w
D	1	Rectangular Worksurface With End Panel, 24"d x 36w
E	1	Pedestal, 22"d, Box, Box, File
F	1	Overhead Cabinet, Panel-mounted, 15"h x 30"w x 15-1/2"d (min.)

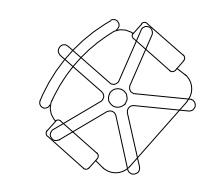

SILLA TIPO A	CANTIDAD 6
	Product Description Silla ejecutiva acojinada con ruedas.

SILLA TIPO B	CANTIDAD 54
	Product Description Silla plastica color negro, sin ruedas.

PROPOSED MOBILIARIO FLOOR PLAN (SIXTH LEVEL)
SCALE: 3/8" = 1'-0"

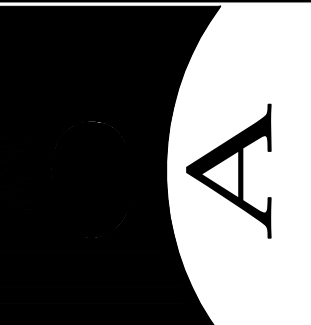

REVISIONS	NO.	DESCRIPTION	DATE	BY

TRIBUNAL GENERAL DE JUSTICIA
OFICINA DE ADMINISTRACION DE LOS TRIBUNALES
DIRECTORIA DE ADMINISTRACION
DIVISION DE LOCALES Y SERVICIOS ESPECIALES

PROJECT NAME: DIGITALIZACION PLANOS DE INSTALACIONES DEL T.G.J.	DRAWING DATE: 16-OCTUBRE-2025
PROJECT LOCATION: 6 to. PISO DEL CENTRO JUDICIAL DE AGUADILLA	SHEET: 1
PLANTA EXISTENTE DEL SEXTO PISO (AS-BUILT)	CHECKED BY: INCDANIEL PAULLA