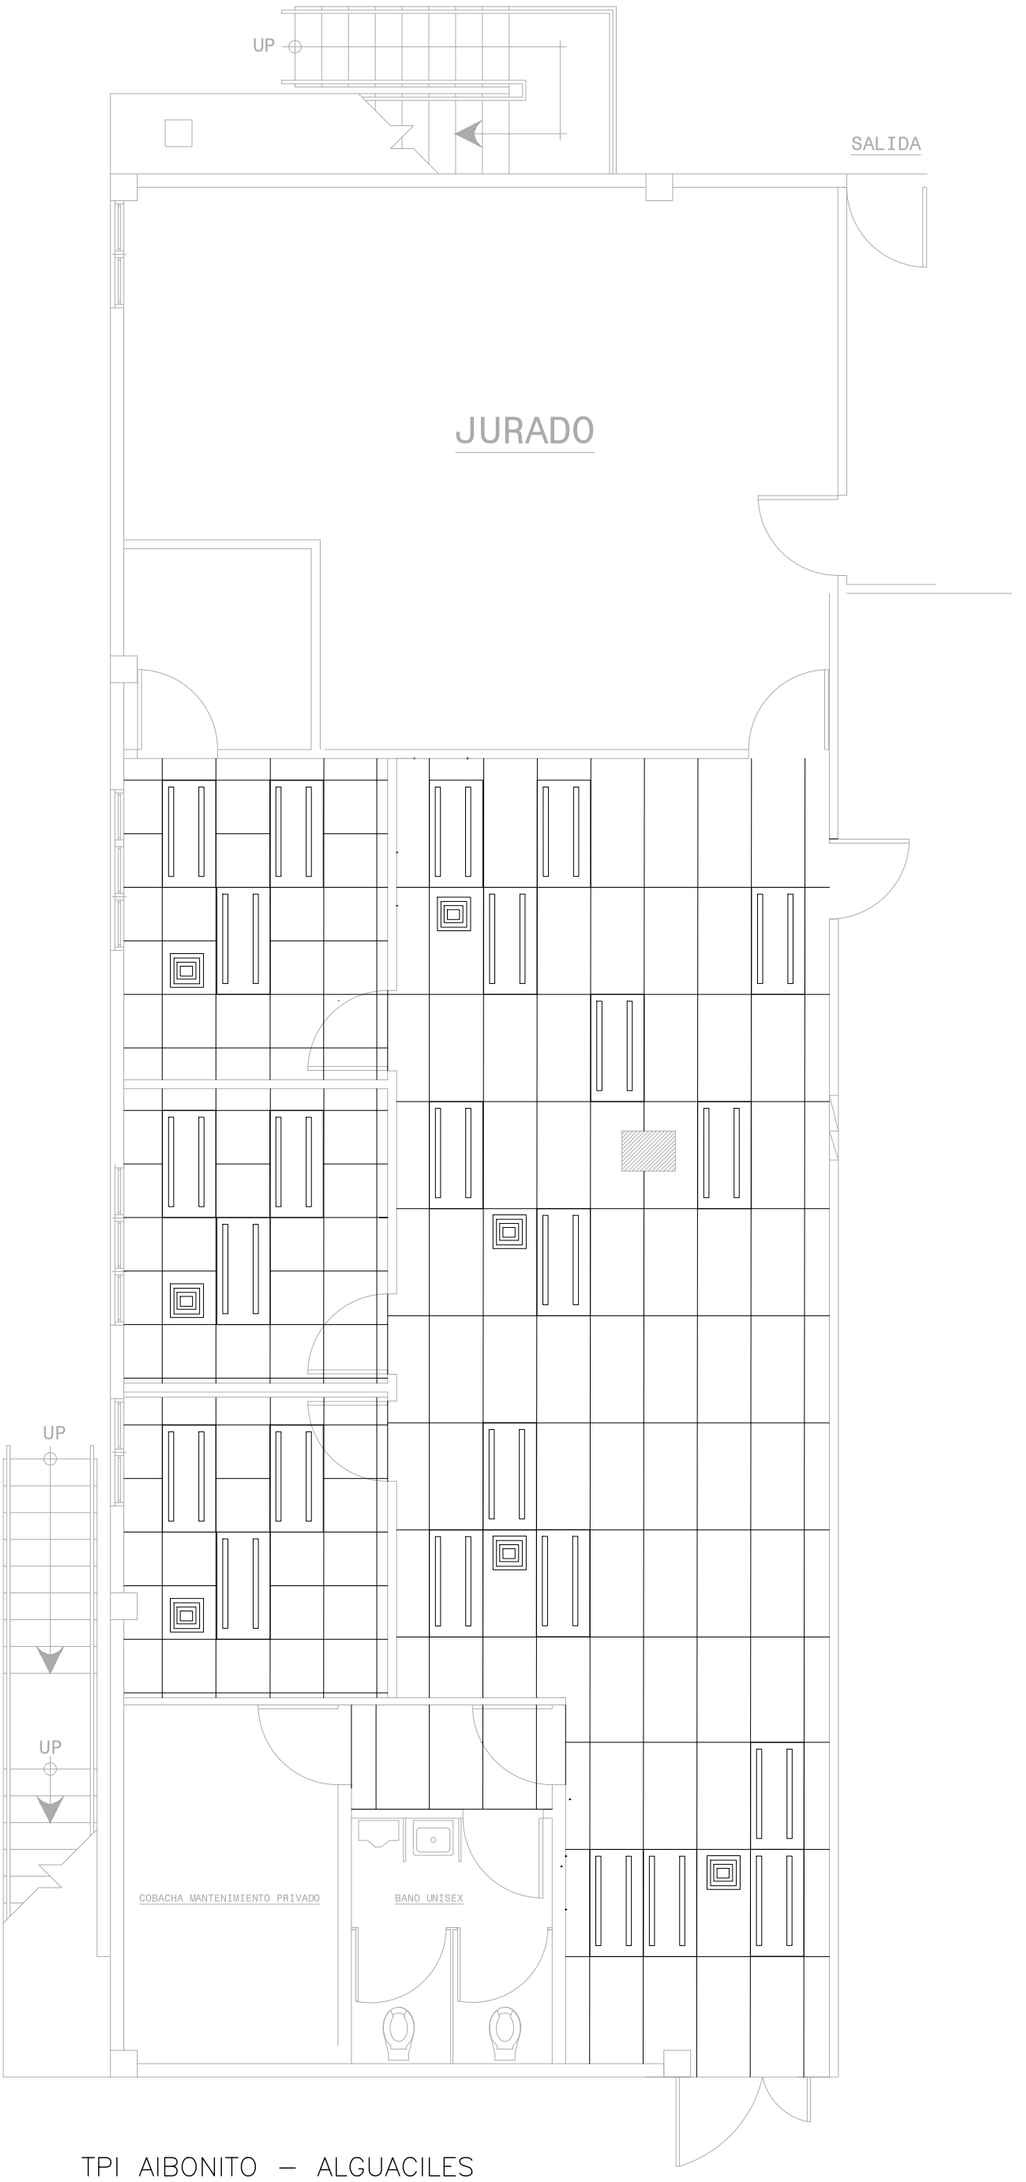

TPI AIBONITO – ALGUACILES
PLANTA DE PISO
AS–BUILT – ACUSTICOS

ESCALA: 3/8"=1'–0"

PROJECT NAME:	AREA DE ALCALDES
PROJECT LOCATION:	CENTRO JUDICIAL DE AIBONITO, AIBONITO
DRAWING DESCRIPTIONS:	AS BUILT - ACÚSTICOS, LUCES, Y DIFUSORES EXISTENTES
ESPEC. EN ADMINIST.	JOEL CARRION
GERENTE DE PROYECTO:	
CHECKED BY:	ING. DANIEL PADILLA
PROJECT DATE:	19/2/2024
DRAWING BY:	PETER RUBI
PRINTING DATE:	19/02/2024
FILE NAME:	
DRAWING SCALE:	3/8" =1'-0"
SHEET NO.	A-2

TRIBUNAL GENERAL DE JUSTICIA
OFICINA DE ADMINISTRACION DE LOS TRIBUNALES
DIRECTORIA DE ADMINISTRACION
OFICINA DE ADMINISTRACION Y CONSERVACION DE LOCALES

APPROVED BY:

APPROVED SIGN: _____ APPROVED DATE:

REVISIONS

NO.	DESCRIPTION	DATE	BY

A
T