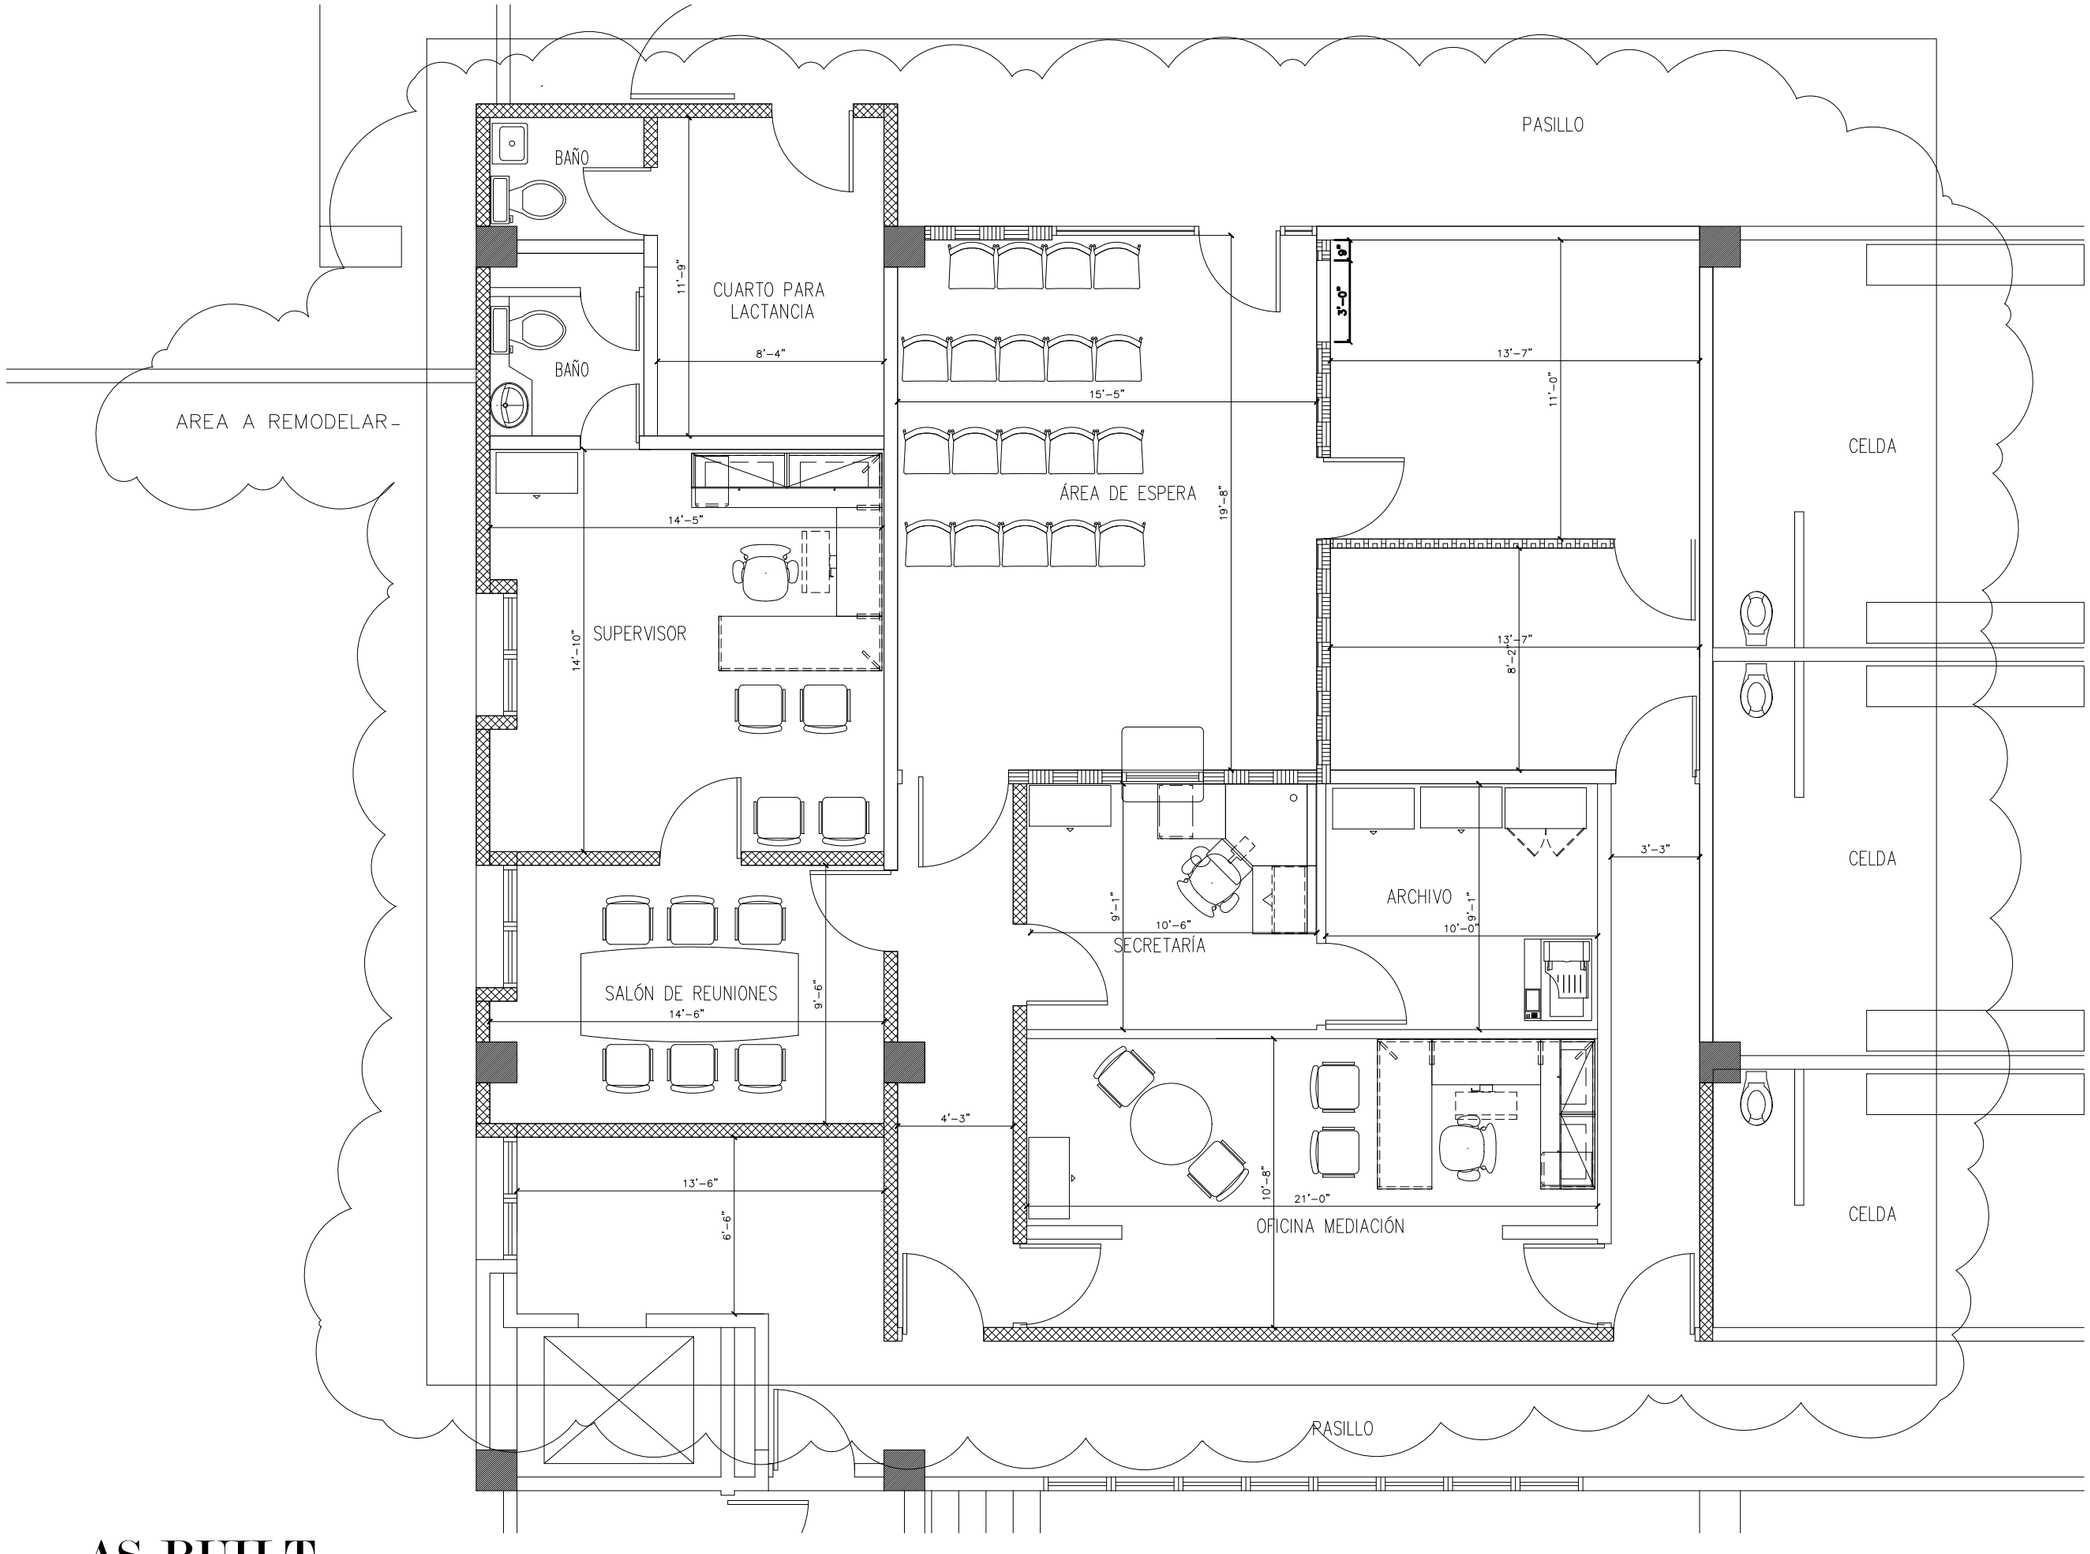

AS-BUILT

ESCALA: 3/8"=1'-0"

PARED GYPSUM BOARD

PARED CONCRETO

PARED MARMOL

REVISIONS

NO.	DESCRIPTION	DATE	BY

TRIBUNAL GENERAL DE JUSTICIA
OFICINA DE ADMINISTRACION DE LOS TRIBUNALES
DIRECTORIA DE ADMINISTRACION
DIVISION DE LOCALES Y SERVICIOS ESPECIALES

APPROVED BY:

APPROVED DATE:

PROJECT NAME: SALA ESPECIALIZADA EN VIOLENCIA DE GÉNERO

PROJECT LOCATION: PRIMER PISO CENTRO JUDICIAL DE GUAYAMA

DRAWING DESCRIPTIONS: PLANTA AS-BUILT

ESPEC. EN ADMINIS: JOEL CARRION

CHECKED BY: ING DANIEL PADILLA

DRAWING BY: PETER RUBI

PROJECT DATE: 4 agosto 2023

DRAWING DATE: -

PRINTING DATE: 4 agosto-2023

DRAWING SCALE: 3/8"=1'-0"

FILE NAME:

SHEET NO. 1

OF: